

Survey Map and C.O.B.U.

For the McNulty Water PUD
 Adding a Point of Appropriation (Well)
 Certificate 65072 (T-11498)
 Sec. 12, T 4N, R 2W
 Columbia County, Oregon

RECEIVED

MAY 22 2015


WATER RESOURCES DEPT
 SALEM, OREGON



SCALE: 1" = 200'

LEGEND


- USGS GRID
- TAXLOT LINE
- ROADWAY
- STRUCTURE
- SECTION CORNER
- WELL (P.O.A.)

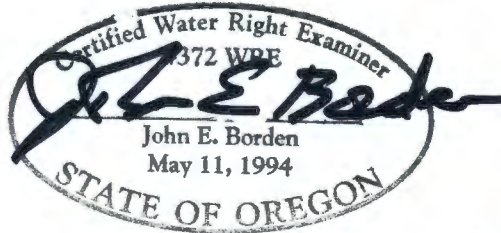

PREPARATION OF THIS MAP IS FOR THE PURPOSE OF IDENTIFYING THE LOCATION OF THE WATER RIGHT ONLY. THERE IS NO INTENT TO PROVIDE DIMENSIONS OR LOCATION OF PROPERTY OWNERSHIP LINES.

SESW

SWSE

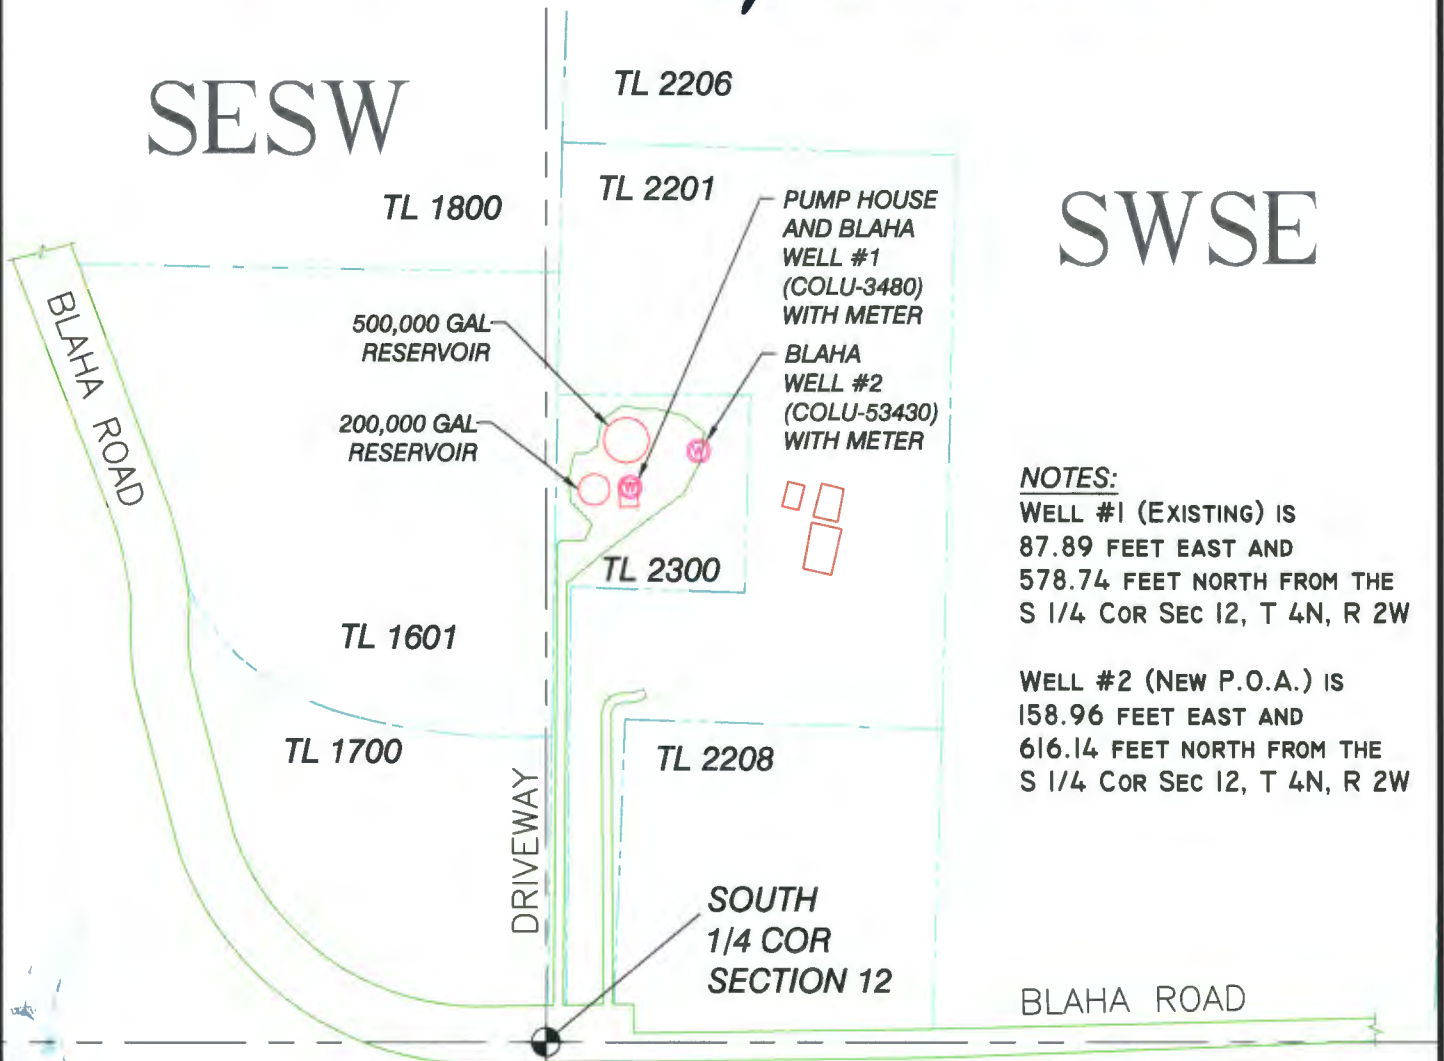

NOTES:

WELL #1 (EXISTING) IS 87.89 FEET EAST AND 578.74 FEET NORTH FROM THE S 1/4 COR SEC 12, T 4N, R 2W

WELL #2 (NEW P.O.A.) IS 158.96 FEET EAST AND 616.14 FEET NORTH FROM THE S 1/4 COR SEC 12, T 4N, R 2W

RECEIVED T4N R1W, T4N R2W, T5N R1W, T5N R2W, W.M.
COLUMBIA COUNTY, OREGON














