


CLAIM OF BENEFICIAL USE
 FOR: MICHAEL CLAGETT
 BY: DUANE W. KIRBY
 T26S, R6W, SE¼ SEC 23 WM
 PERMIT NO S-54296
 FISH SCREEN IS LOCATED AT THE POD
 SCALE · 1" = 500'

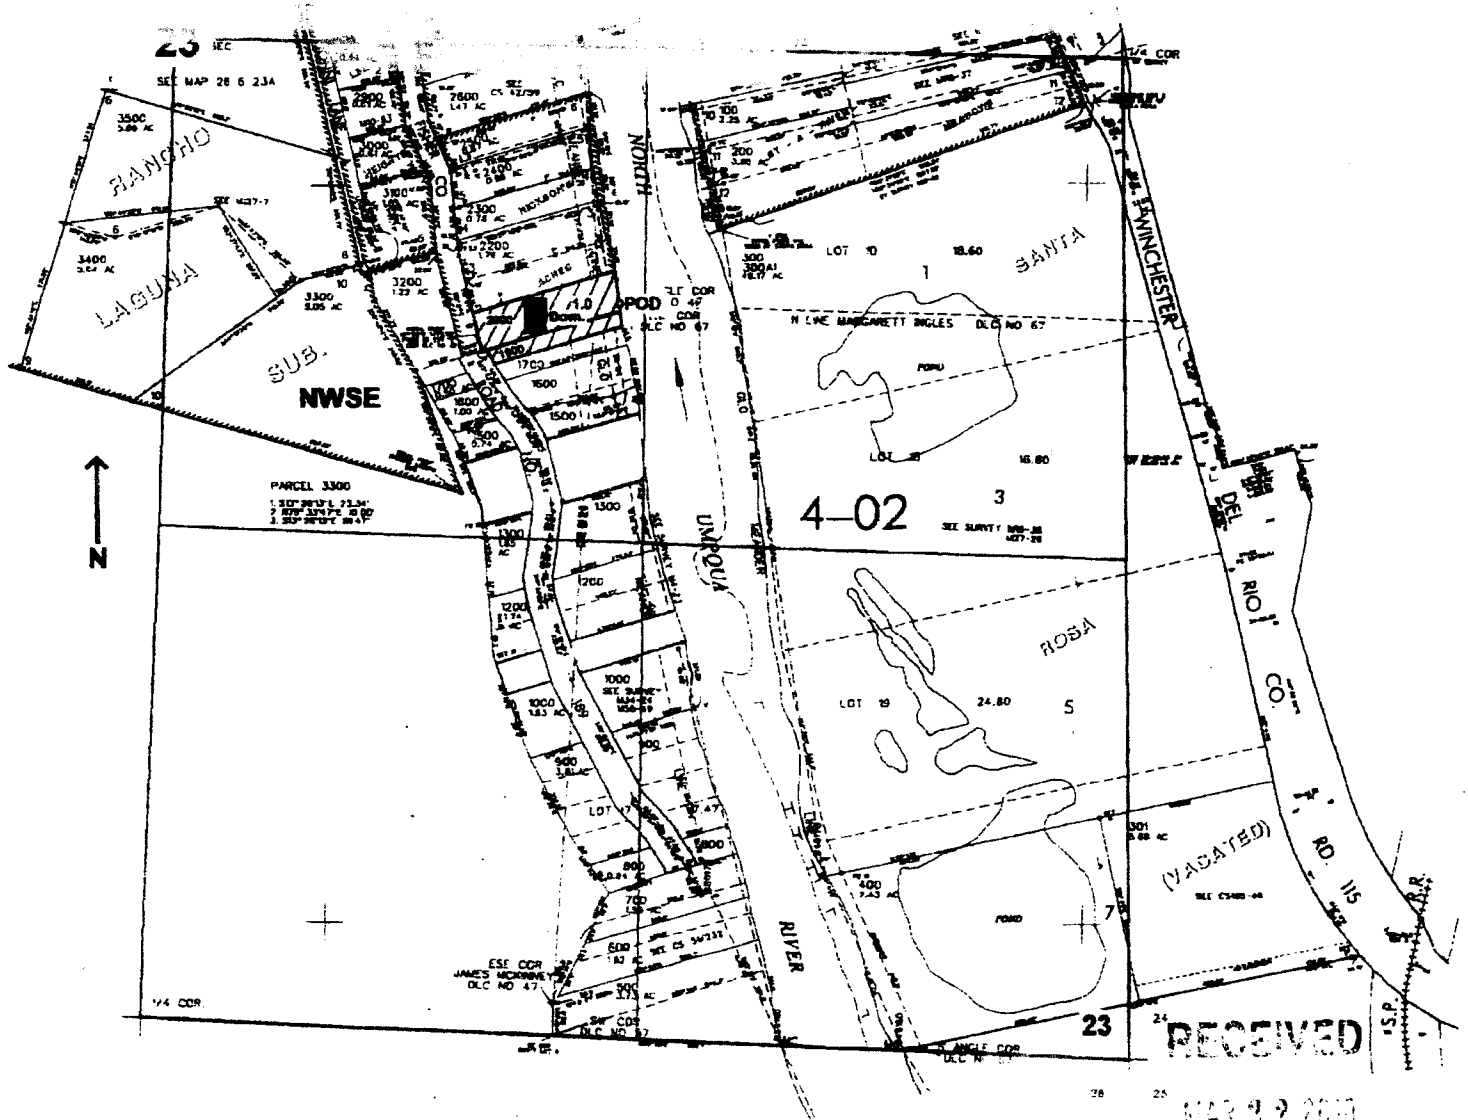

POD is located 710 ft. S. and 1230 ft. W. from the center of Sec. 23

WATER RESOURCES DEPT
 SALEM, OREGON

THE PURPOSE OF THIS MAP IS TO IDENTIFY THE LOCATION OF THE WATER RIGHT. IT IS NOT INTENDED TO PROVIDE INFORMATION RELATIVE TO THE LOCATION OF PROPERTY OWNERSHIP BOUNDARY LINES.

