


CLAIM OF BENEFICIAL USE
 FOR MICHAEL HAMBERG
 BY DUANE W. KIRBY
 T26S, R4W, SEC18
 TAX LOT 1800
 APPLICATION NO S-86329
 PERMIT NO S-54265
 FISH SCREEN IS LOCATED AT THE POD

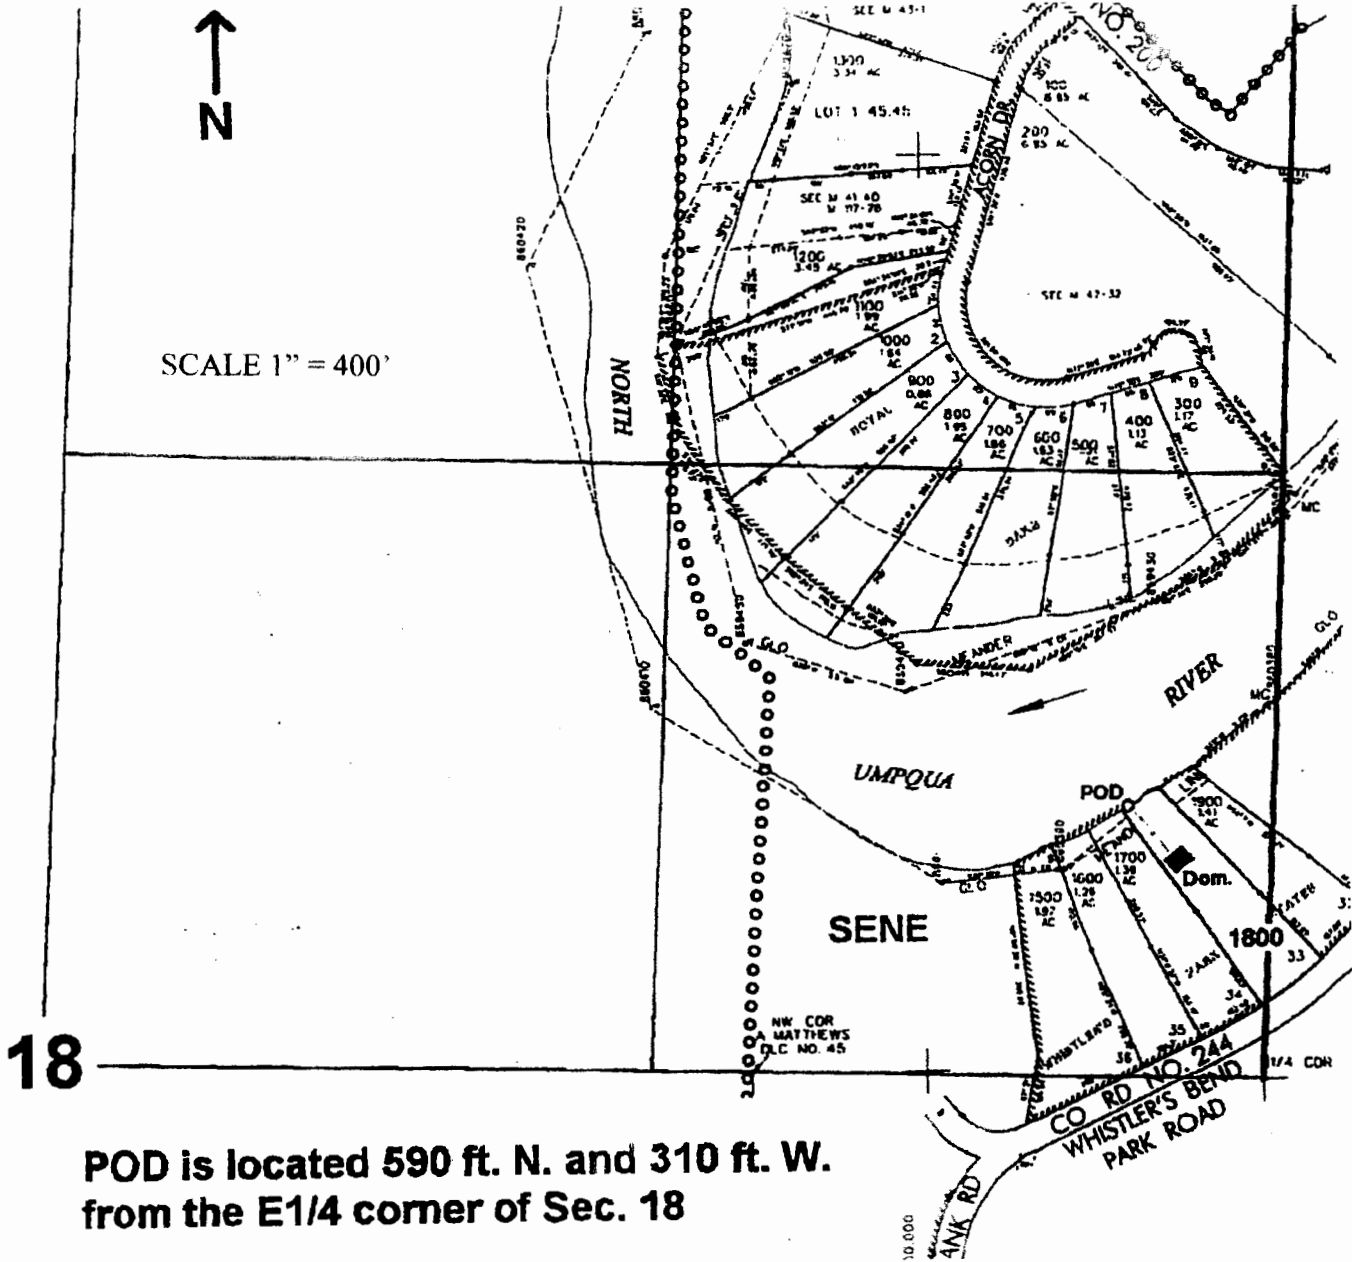

**POD is located 590 ft. N. and 310 ft. W.
 from the E1/4 corner of Sec. 18**

THE PURPOSE OF THIS MAP IS TO IDENTIFY THE LOCATION OF THE WATER RIGHT. IT IS NOT INTENDED TO PROVIDE INFORMATION RELATIVE TO THE LOCATION OF PROPERTY OWNERSHIP BOUNDARY LINES.

