

LAND WITHIN JOSEPH MUNICIPAL SERVICE AREA


T 25, R 45E

SEC 29	SW 1/4, NW 1/4	14.7 AC
	NE 1/4, SW 1/4	30.0 AC
	NW 1/4, SW 1/4	39.4 AC
	SW 1/4, SW 1/4	39.7 AC
	SE 1/4, SW 1/4	21.2 AC
SEC 30	SE 1/4, NE 1/4	4.1 AC
	NE 1/4, SE 1/4	40.0 AC
	NW 1/4, SE 1/4	30.9 AC
	SW 1/4, SE 1/4	15.2 AC
	SE 1/4, SE 1/4	40.0 AC
	NE 1/4, SW 1/4	38.6 AC
	NW 1/4, SW 1/4	3.2 AC
	SE 1/4, SW 1/4	13.6 AC
SEC 31	NE 1/4, NE 1/4	38.2 AC
	SW 1/4, NE 1/4	1.8 AC
	SE 1/4, NE 1/4	37.2 AC
	NE 1/4, SE 1/4	19.4 AC
	SE 1/4, SE 1/4	15.5 AC
SEC 32	NE 1/4, NW 1/4	26.5 AC
	NW 1/4, NW 1/4	38.8 AC
	SW 1/4, NW 1/4	39.4 AC
	SE 1/4, NW 1/4	33.2 AC
	SW 1/4, NE 1/4	0.1 AC
	NE 1/4, SE 1/4	6.9 AC
	NW 1/4, SW 1/4	37.0 AC
	SE 1/4, SW 1/4	42.4 AC
	SE 1/4, SW 1/4	2.0 AC

T 35, R 45E  
SECS 5 NW 1/4, NW 1/4 11.0 AC

- LAND WITHIN JOSEPH CITY LIMITS
- LAND WITHIN JOSEPH URBAN GROWTH BOUNDARY BUT OUTSIDE CITY LIMITS

RECEIVED

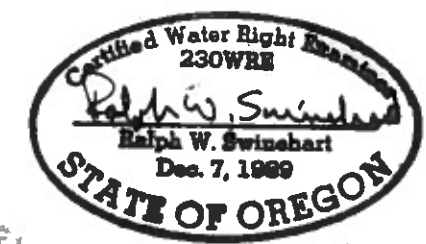


WATER RESOURCES DEPT.  
SALEM, OREGON

BASIS OF MAP IS 1990 JOSEPH, OREGON ORTHOPHOTO QUAD MAP, AERIAL PHOTOS, AND COUNTY ASSESSOR MAPS. IT IS PREPARED FOR WATER RIGHT PURPOSES ONLY AND SHOULD NOT BE USED FOR PROPERTY LOCATION PURPOSES.

THE PURPOSE OF THIS MAP IS TO TRANSFER 480 AC FT OF STORED WATER IN WALLOWA LAKE HELD BY THE ASSOCIATED DITCH CO. TO THE CITY OF JOSEPH FOR GENERAL MUNICIPAL USE WITHIN ITS MUNICIPAL SERVICE AREA

CITY OF JOSEPH, IN WALLOWA COUNTY  
STORAGE RIGHT TRANSFER FINAL PROOF MAP  
APPLICATION NO. 9-0337; PERMIT NO. 53560

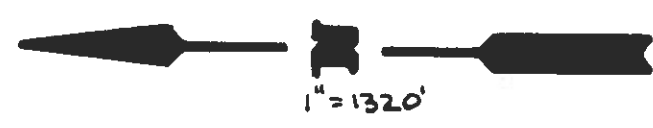

COBU MAP # 0351

DATE 3/03	<b>WALLOWA MOUNTAIN ENGINEERING</b> PO BOX 288 ENTERPRISE, OREGON 97820 426-4086	REVISIONS	SHEET
JOB 96764			1
DESIGN DJS			OF
DRAWN DJS			