

CLAIM OF BENEFICIAL USE MAP


T. 30 S., R. 3 E., Section 26, Taxlot 100

Application: S-87310 Permit: S-54572

WATER RESOURCES DEPT
MAY 14 2002



Scale 1" = 1320'

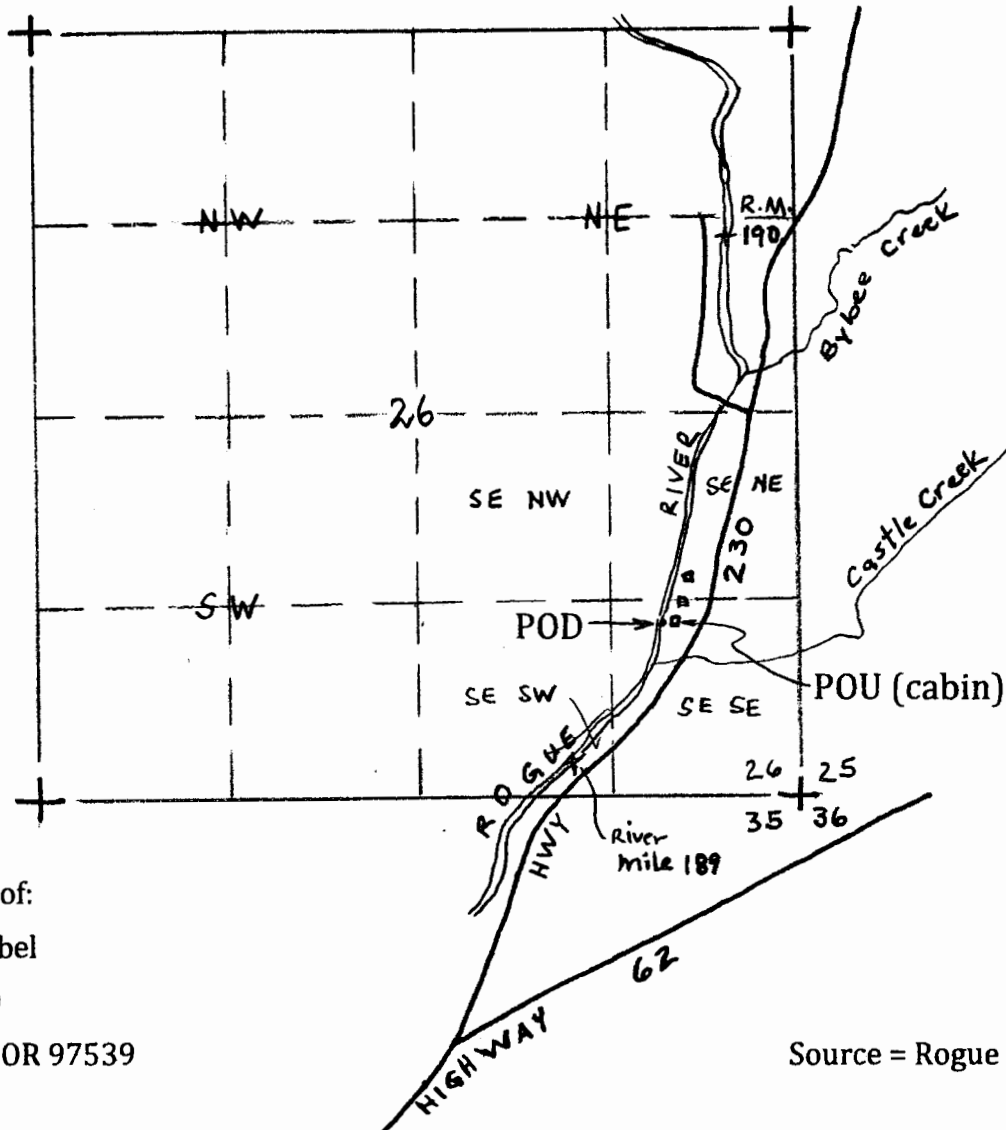

In the name of:
Richard Goebel
P.O. Box 990
Shady Cove, OR 97539

Source = Rogue River

POD is located 1000 feet North and 1150 feet West of SE Corner of Section 26.

GPS coordinates are: 42° 55' 43.11" N & 122° 25' 23.24" W

NOTE: This map is for water rights purposes, not for property boundary locations.



RENEWAL DATE: 6-30-2011

Map by Bob Jones on May 23, 2010