


T.8S. R.2W., W.M., Sec. 9

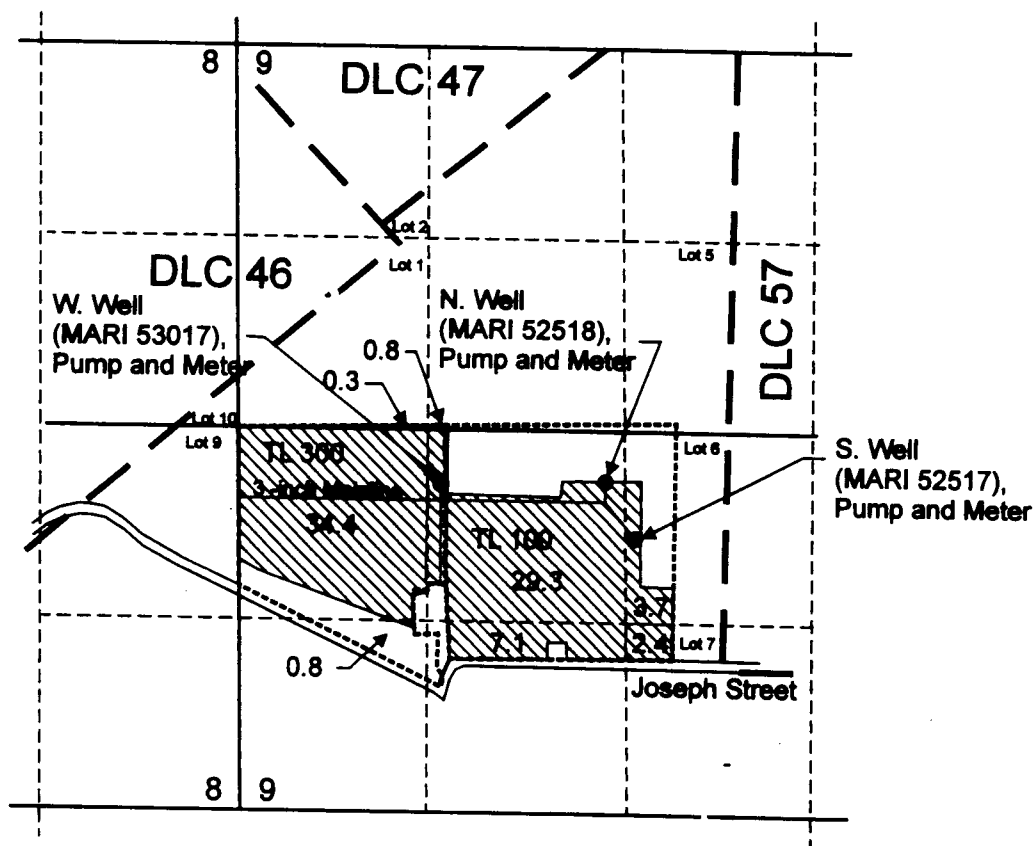

N. Well is located 340 feet south and 2,520 feet east of the west 1/4 corner of Section 9.
 S. Well is located 730 feet south and 2,720 feet east of the west 1/4 corner of Section 9.
 W. Well is located 370 feet south and 1,385 feet east of the west 1/4 corner of Section 9.



Area (78.8 Acres) irrigated under Application G-14704, Permit G-13761.



3-inch Mainline

RECEIVED

OCT 01 2008

WATER RESOURCES DEPT
 SALEM, OREGON



EXPIRATION DATE: 6/30/09

Scale: 1" = 1,320'



0 1,320
 Feet

This map was prepared for the purpose of identifying the location of a water right only and is not intended to provide legal dimensions or location of property ownership lines.



Claim of Beneficial Use Map
 Applicator G-14704, Permit G-13761

Heritage Seedings, Inc.
 Cherry Farm

Pacific Hydro-Geology Inc.