
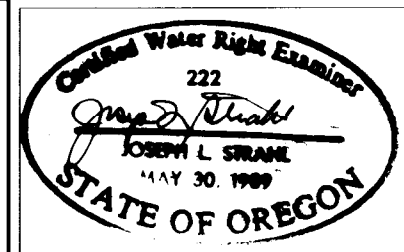


Claim of Beneficial Use Map for Application R-84699, Permit R-13117 T 40 S, R 19 E, Section 28, W.M.


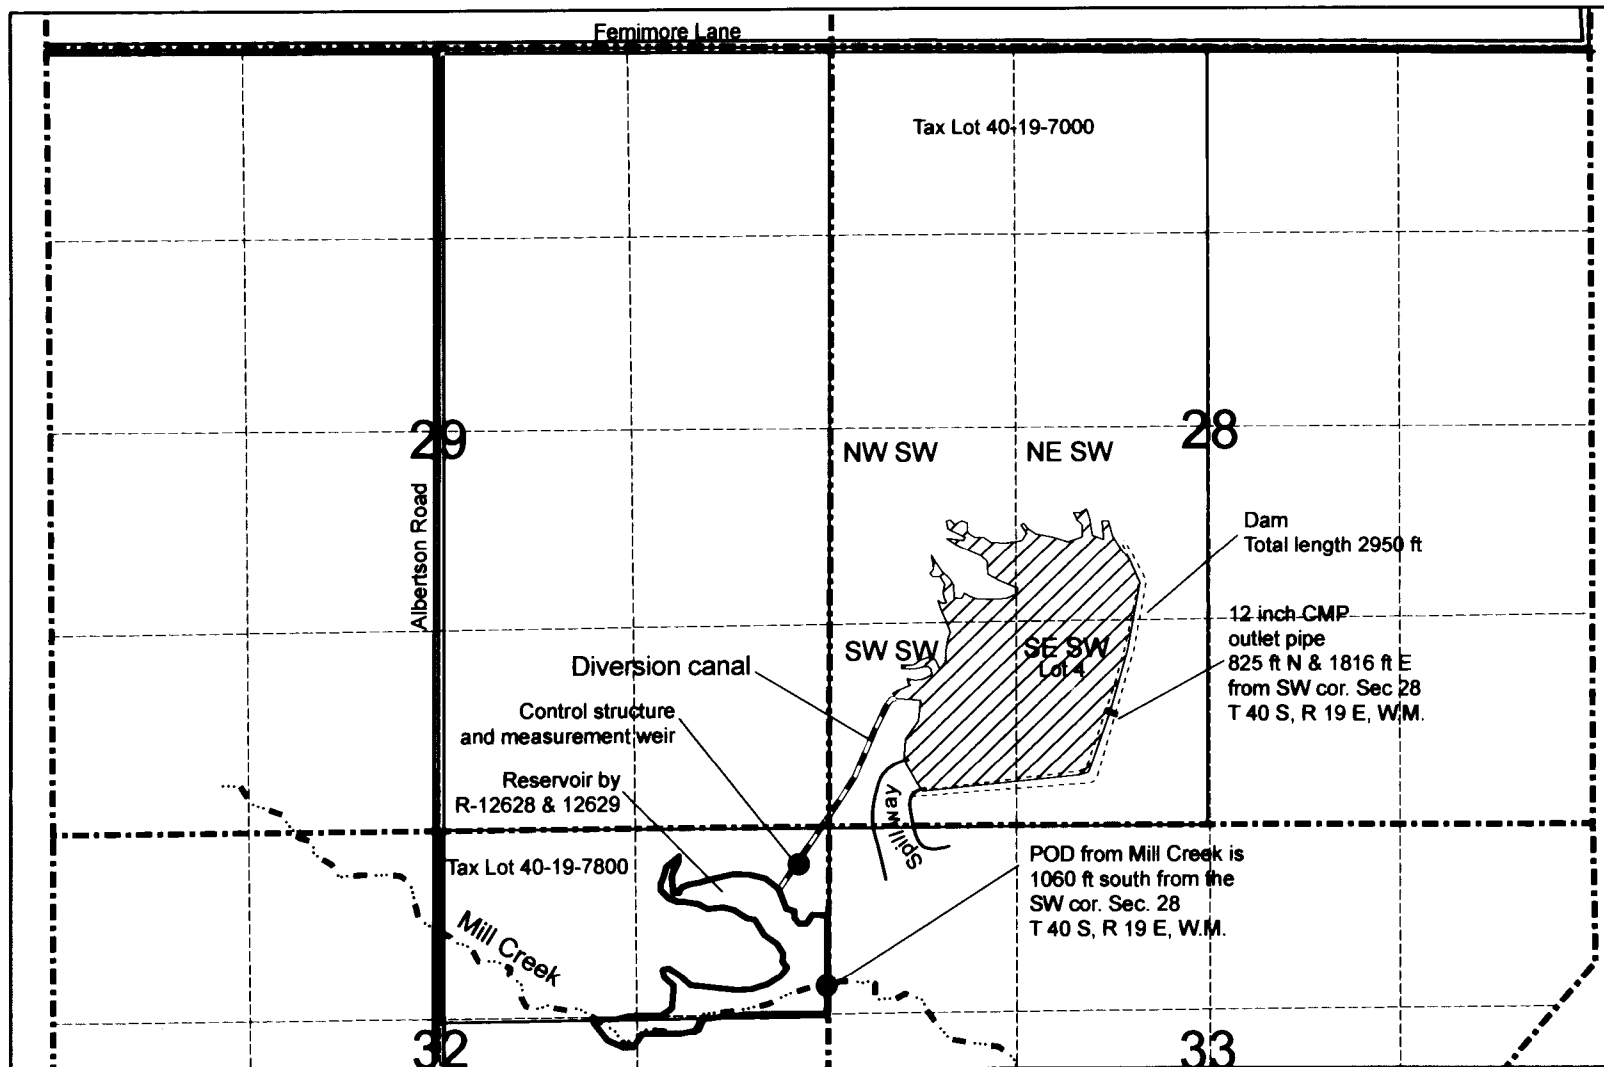

CWRE stamp

Note: This map is not to be used for property line location. It is to be used for water right purposes only.

Legend

R13117



Scale 1" = 1320'