


T.35S.,R.1W.,W.M.  
 Tax Lot No. 351W 32-1000

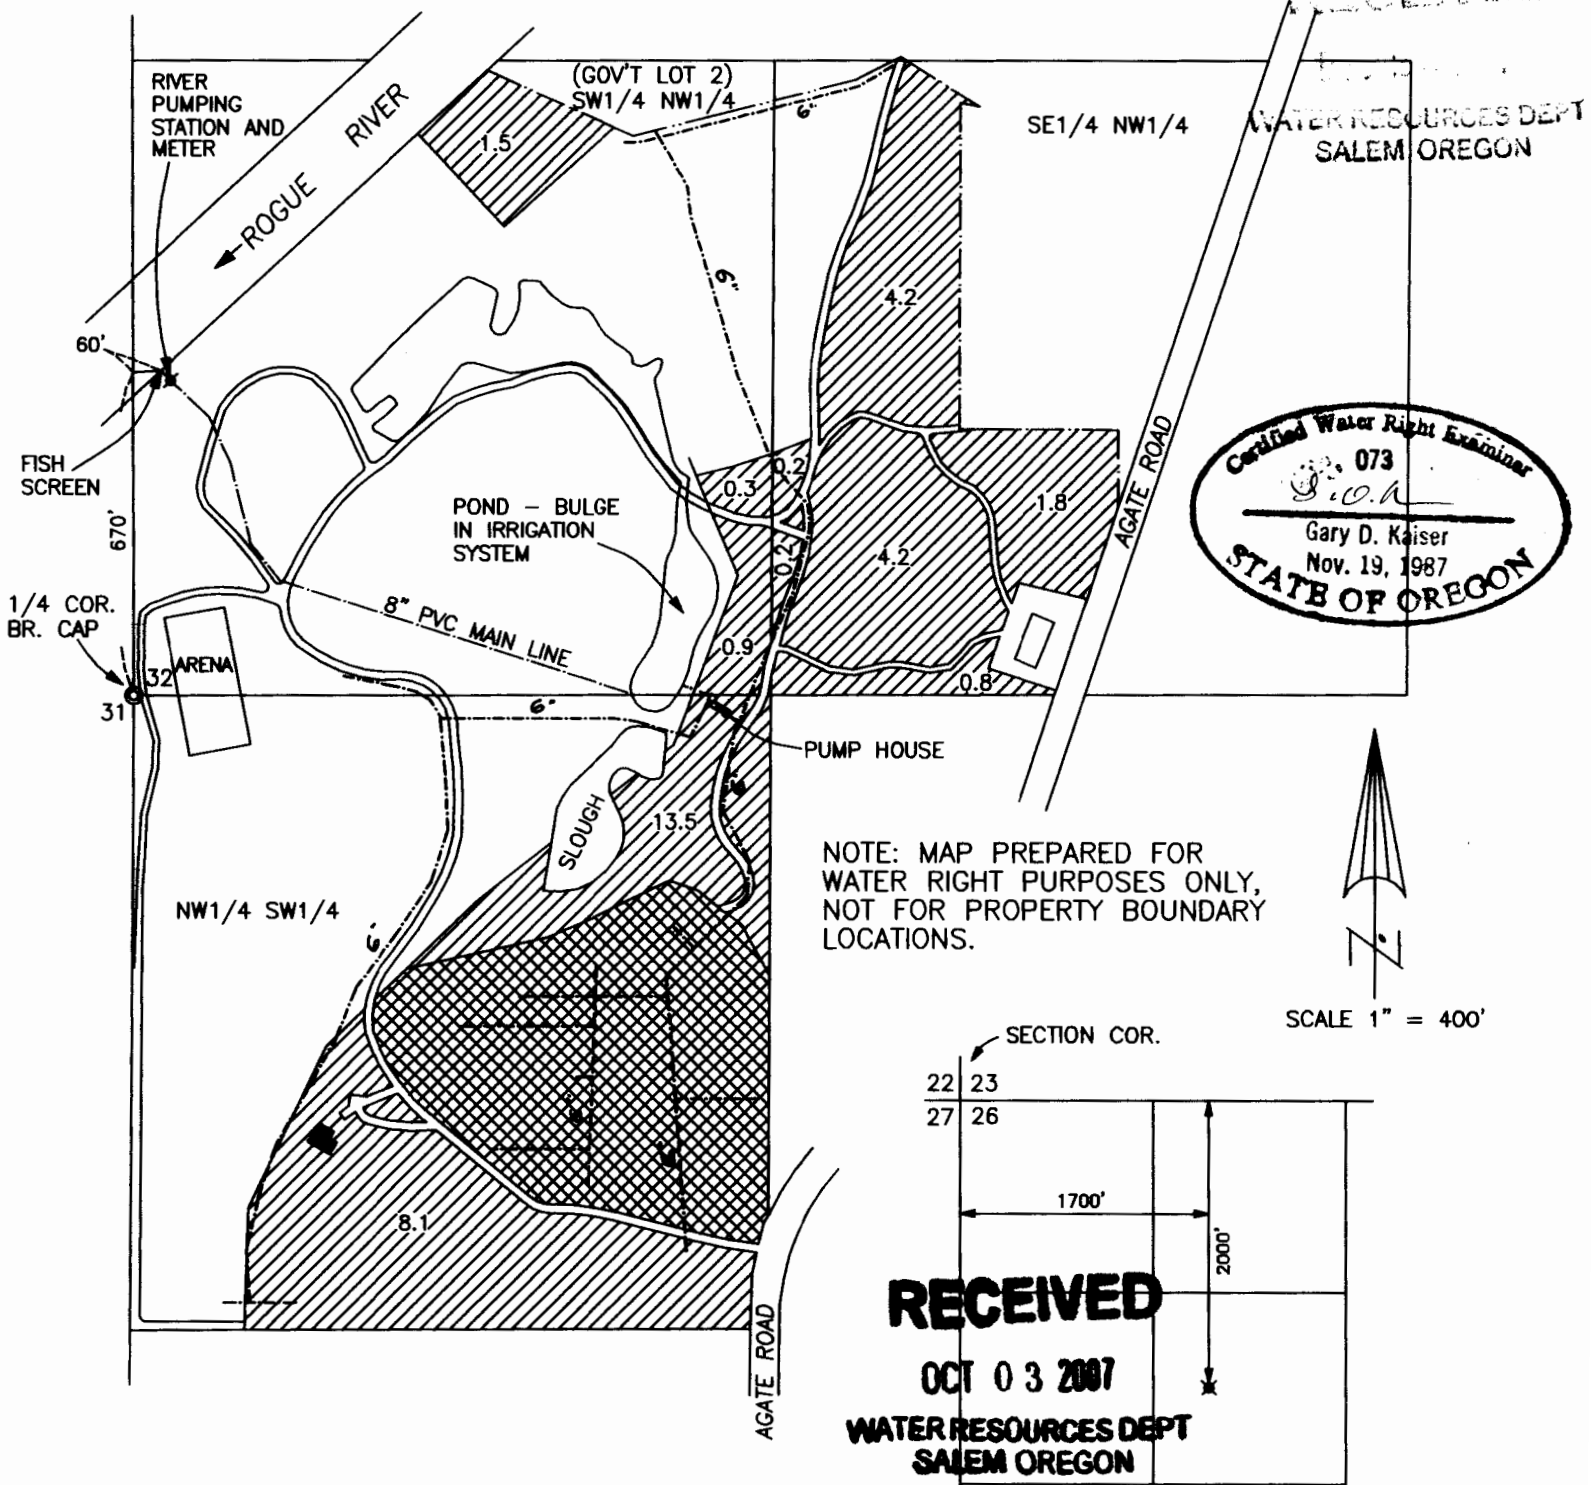


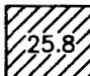
**CLAIM OF BENEFICIAL USE MAP**

APPLICATION NOS. S-84644 AND S-85231  
 PERMIT NOS. 53806 AND 54031

IN THE NAME OF PHEASANTBROOK LLC, JAMES  
 J. BAYER AND TONI ISOLA-BAYER  
 12155 AGATE ROAD  
 EAGLE POINT, OREGON 97524

MAP PREPARED SEPTEMBER 23, 2007  
 BY GARY D. KAISER

LOST CREEK RESERVIOR  
 POINT OF DIVERSION  
 T.33S.,R.1E.,W.M.  
 SCALE 1" = 1320'

-  9.9 = AREA IRR. BY SOLED SET GUNS - SEE EXHIBIT MAP
-  25.8 = AREA IRR. BY GUNS ON PORTABLE CARTS

# EXHIBIT MAP

## AREA IRRIGATED BY SOLID SET BIG GUNS

RECEIVED

OCT 03 2007


WATER RESOURCES DEPT  
SALEM OREGON

1/4 CO..  
BR. CAP

32


31

NW1/4 SW1/4

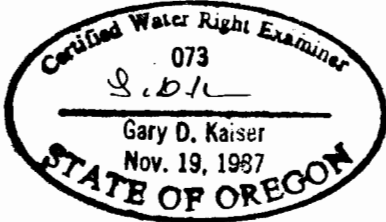

PUMP  
HOUSE

SLOUGH

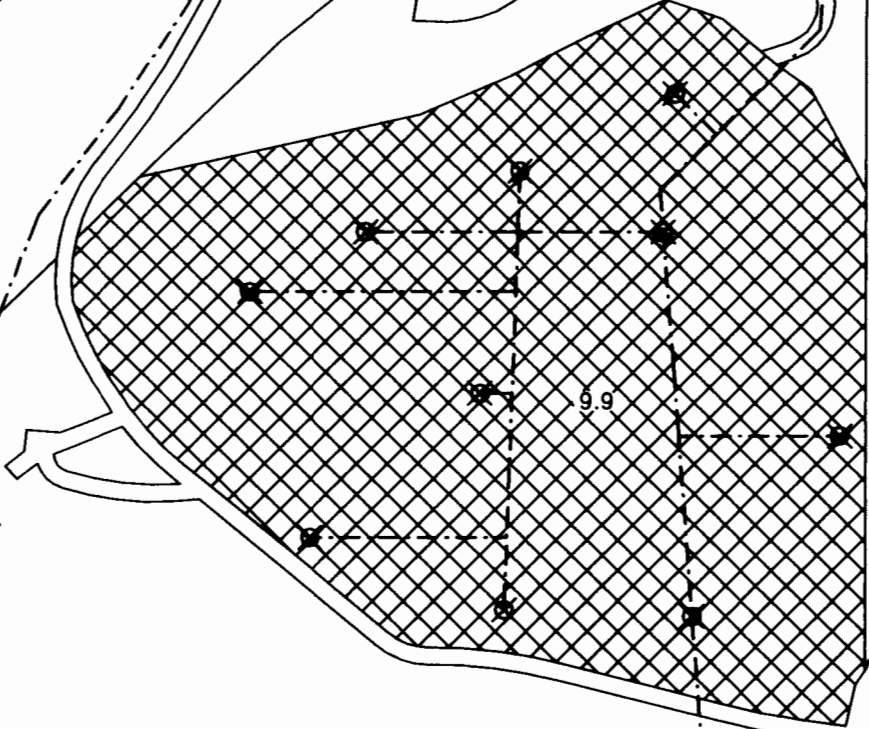


RECEIVED

OCT 03 2007

WATER RESOURCES DEPT  
SALEM OREGON

AGATE ROAD

- - - - - = 6" BURIED PVC LATERALS
- - - - - X = SOLID SET BIG GUNS  
1.1" NOZZLE
-  = AREA IR.. BY SOLID SET  
GUNS - SEE EXHIBIT MAP



SCALE 1" = 200'