


T.15S., R.5W., W.M. SECTION 6

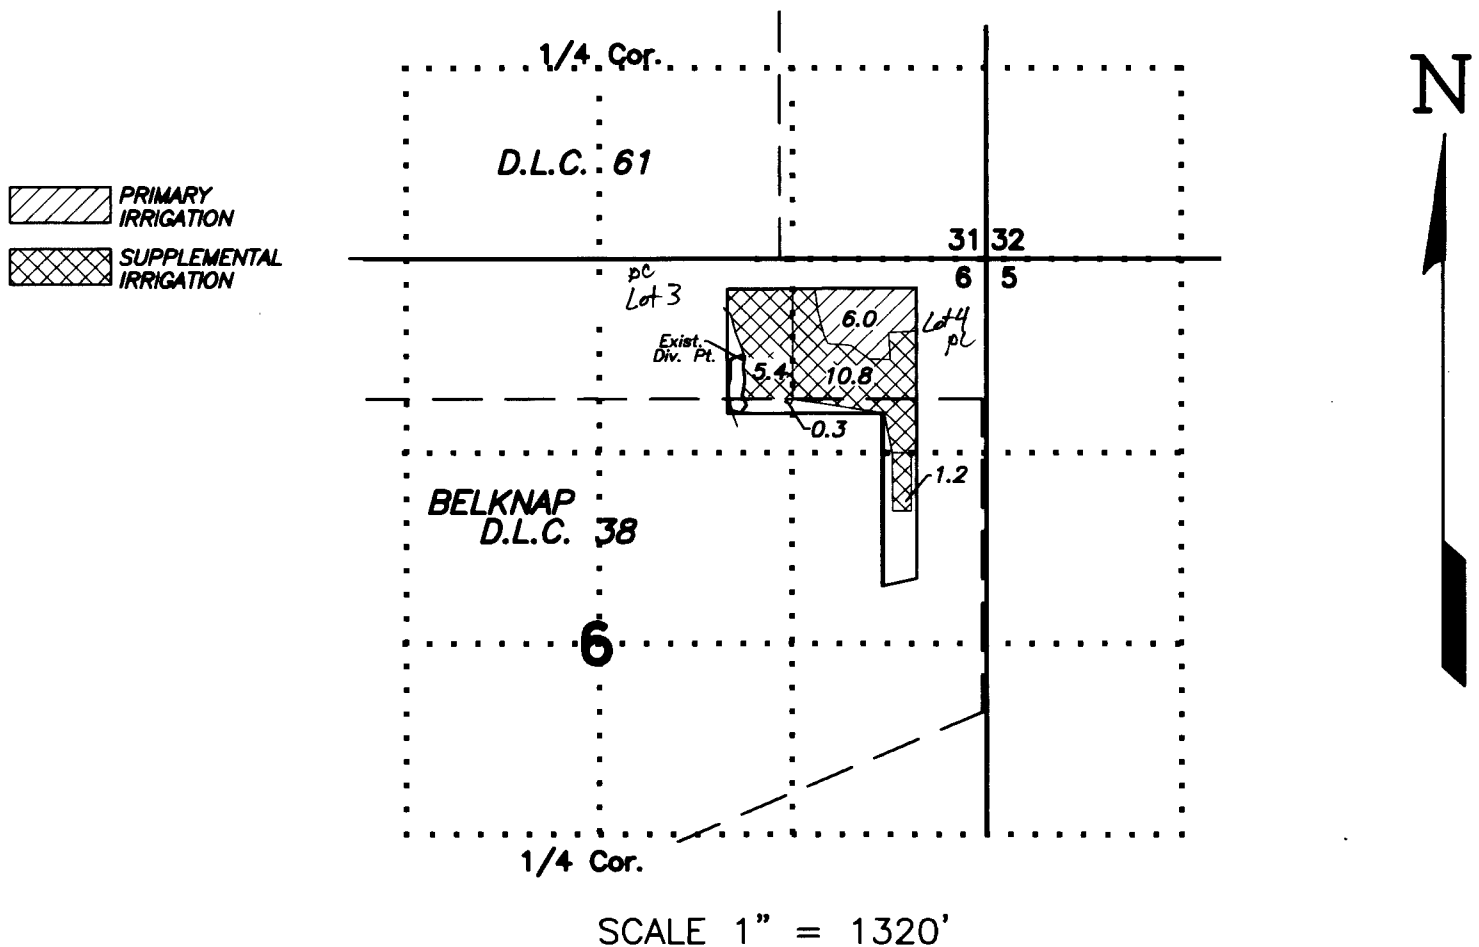

THE POINT OF DIVERSION IS LOCATED IN THE NW 1/4 NE 1/4, SECTION 6, T15S, R5W, W.M.; 755 FEET SOUTH & 2200 FEET EAST FROM THE ~~NW CORNER, SECTION 6~~ *W 1/4 Corner between sections 6 & 31 PC/WREB 7/17/2015*



FINAL PROOF SURVEY

UNDER

Application No. S-85073 Permit No. 53906

IN THE NAME OF

RECEIVED

JOHN & REBECCA HAFFLEY

JUN 28 2007

WATER RESOURCES DEPT
SALEM, OREGON

Surveyed MAY 13 2007 by JON HARTWELL

THE PURPOSE OF THIS MAP IS TO IDENTIFY THE LOCATION OF THE WATER RIGHT. IT IS NOT INTENDED TO PROVIDE INFORMATION RELATIVE TO THE LOCATION OF PROPERTY OWNERSHIP BOUNDARY LINES.