



SECTION 6

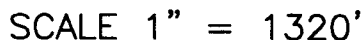

THE RESERVOIR IS LOCATED IN THE NW 1/4 NE 1/4, SECTION 6, T15S, R5W, W.M.; 755 FEET SOUTH & 2200 FEET EAST FROM THE W 1/16 CORNER BETWEEN SECTIONS 6 & 31. THE AREA SUBMERGED BY THE RESERVOIR IS LOCATED IN IN THE NW 1/4 NE 1/4 SECTION 6.

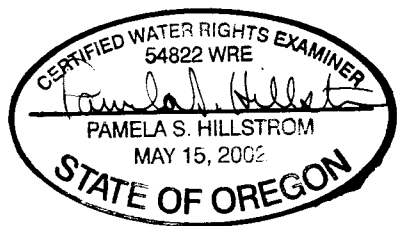

FINAL PROOF SURVEY

UNDER

Application No. R-85074 Permit No. R-13279
IN THE NAME OF

JOHN & REBECCA HAFFLEY

EXPIRATION DATE: 6/30/

RECEIVED

JUN 28 2007

**WATER RESOURCES DEPT
SALEM, OREGON**

SurveyedMAY 13..... 20..07.. by JON HARTWELL

THE PURPOSE OF THIS MAP IS TO IDENTIFY THE LOCATION OF THE WATER RIGHT. IT IS NOT INTENDED TO PROVIDE INFORMATION RELATIVE TO THE LOCATION OF PROPERTY OWNERSHIP BOUNDARY LINES.

Government lots added to map
PL/WRD 7/17/2015