

T6N, R34E, WM
Section 24
Umatilla County



1 inch = 400 feet

FRUITVALE ROAD

Little Mud Creek

TL 100

37.0

13 18

24 19

HIGHWAY 332

R34E

R35E


REC-1121
APR 30 2007
WATER RESOURCES
SALEM OREGON

● **Authorized POA**
Groundwater well in gravel aquifer located in NE/4, NE/4, Section 24, at a distance 1280 feet S and 530 feet W from NE Corner of Section 24. Flowmeter in same location.

----- **Conveyance**
5-inch mainline feeding 3-inch diameter aluminum handline. Water applied with Nelson F33 brass impact sprinklers with 11/64-inch nozzles.

 **Place of Use**
37.0 acres in NE/NE Sec 24

The purpose of this map is to identify the location of a water right. It is not intended to provide information regarding the location of property ownership boundary lines.

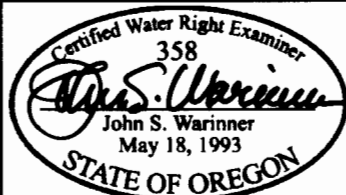

FOUNTAINHEAD
1860 Blue Creek Road
Walla Walla, WA 99362
509.529.2646 phone

FINAL PROOF SURVEY

**Application G-16623
Permit G-16123**

in the name of
CURCIO FARMS, LLC

Revised 20 JUN 2007