
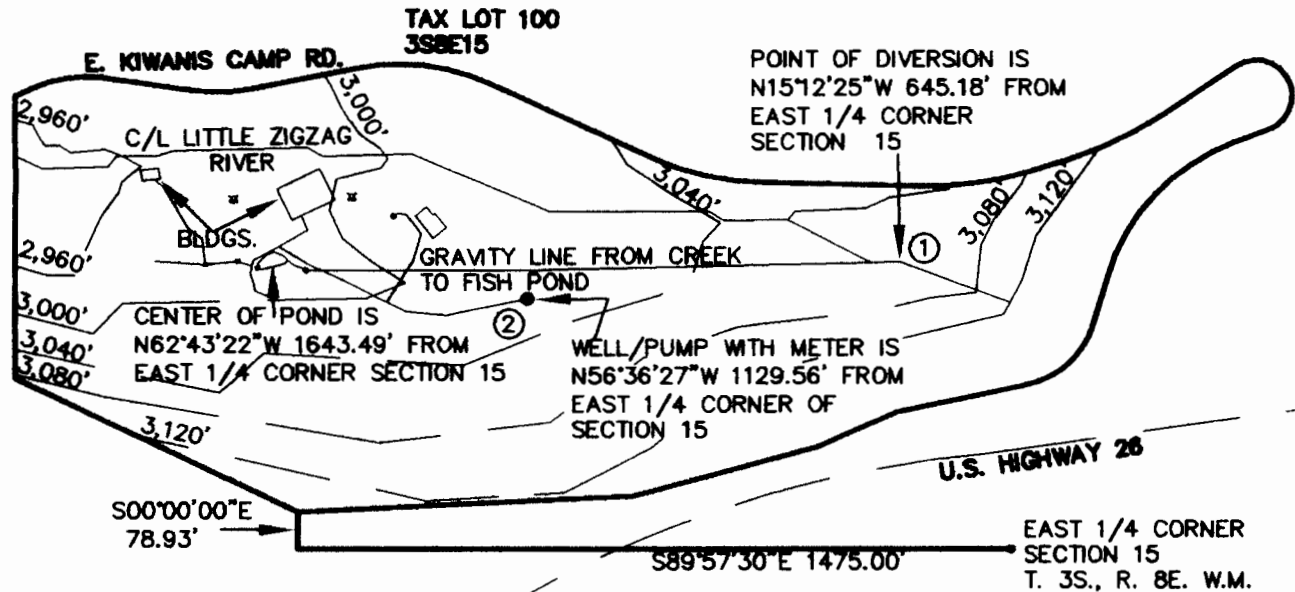
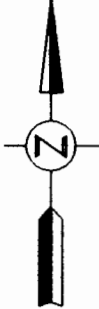


CLAIM OF BENEFICIAL USE MAP

LOCATED IN THE N.E. 1/4 OF SECTION 15
TOWNSHIP 3 SOUTH, RANGE 8 EAST, W.M.
CLACKAMAS COUNTY, OREGON
SCALE: 1" = 400' FEBRUARY 22, 2007

APPLICATION NO.
R-70168
S-70169

PERMIT NO.
R-11883
52600

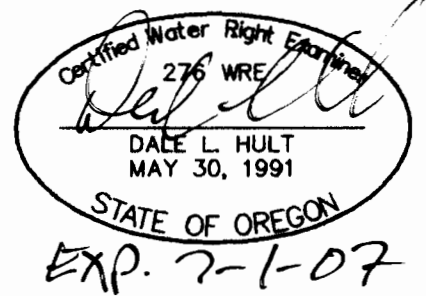

RECEIVED
FEB 27 2007

WATER RESOURCES DEPT
SALEM OREGON

RECEIVED

FEB 13 2009

WATER RESOURCES DEPT
SALEM, OREGON

CLIENT: GENE NUDELMAN

THIS DRAWING IS NOT A LAND SURVEY. PROPERTY LINES
AND/OR OTHER LINES OF OCCUPATION SHOWN HEREON ARE
NOT REPRESENTED BY THE UNDERSIGNED TO MEET
ACCURACY STANDARDS OF LAND SURVEYS.
TOPOGRAPHIC INFORMATION IS TAKEN FROM USGS QUAD
MAPS AND IS FOR GRAPHIC PURPOSES ONLY.



06-075.DWG DATE OF PLOT: 1/30/2007

original mylar map in R70168