
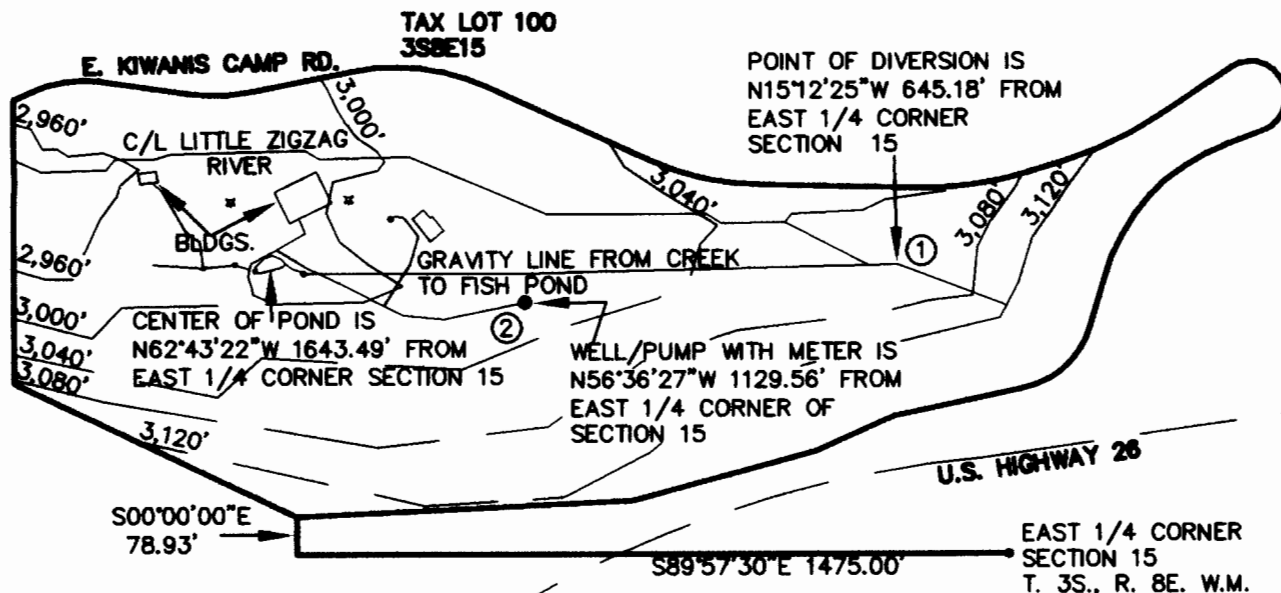
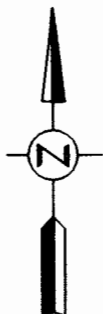


**CLAIM OF
BENEFICIAL USE MAP**

LOCATED IN THE N.E. 1/4 OF SECTION 15
TOWNSHIP 3 SOUTH, RANGE 8 EAST, W.M.
CLACKAMAS COUNTY, OREGON
SCALE: 1" = 400' FEBRUARY 22, 2007

APPLICATION NO.
R-70188
S-70188

PERMIT NO.
R-11683
52800

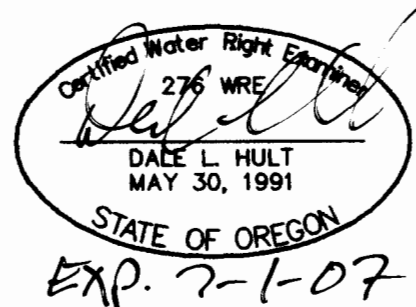

RECEIVED

FEB 27 2007

WATER RESOURCES DEPT
SALEM OREGON

RECEIVED

FEB 13 2009

WATER RESOURCES DEPT
SALEM, OREGON

THIS DRAWING IS NOT A LAND SURVEY. PROPERTY LINES
AND/OR OTHER LINES OF OCCUPATION SHOWN HEREON ARE
NOT REPRESENTED BY THE UNDERSIGNED TO MEET
ACCURACY STANDARDS OF LAND SURVEYS.
TOPOGRAPHIC INFORMATION IS TAKEN FROM USGS QUAD
MAPS AND IS FOR GRAPHIC PURPOSES ONLY.

CLIENT: GENE NUDELMAN

