FINAL PROOF SURVEY

APPLICATION S-71715 R-71704
PERMIT 52421 R-11849
SCALE 1" - 200 FEET

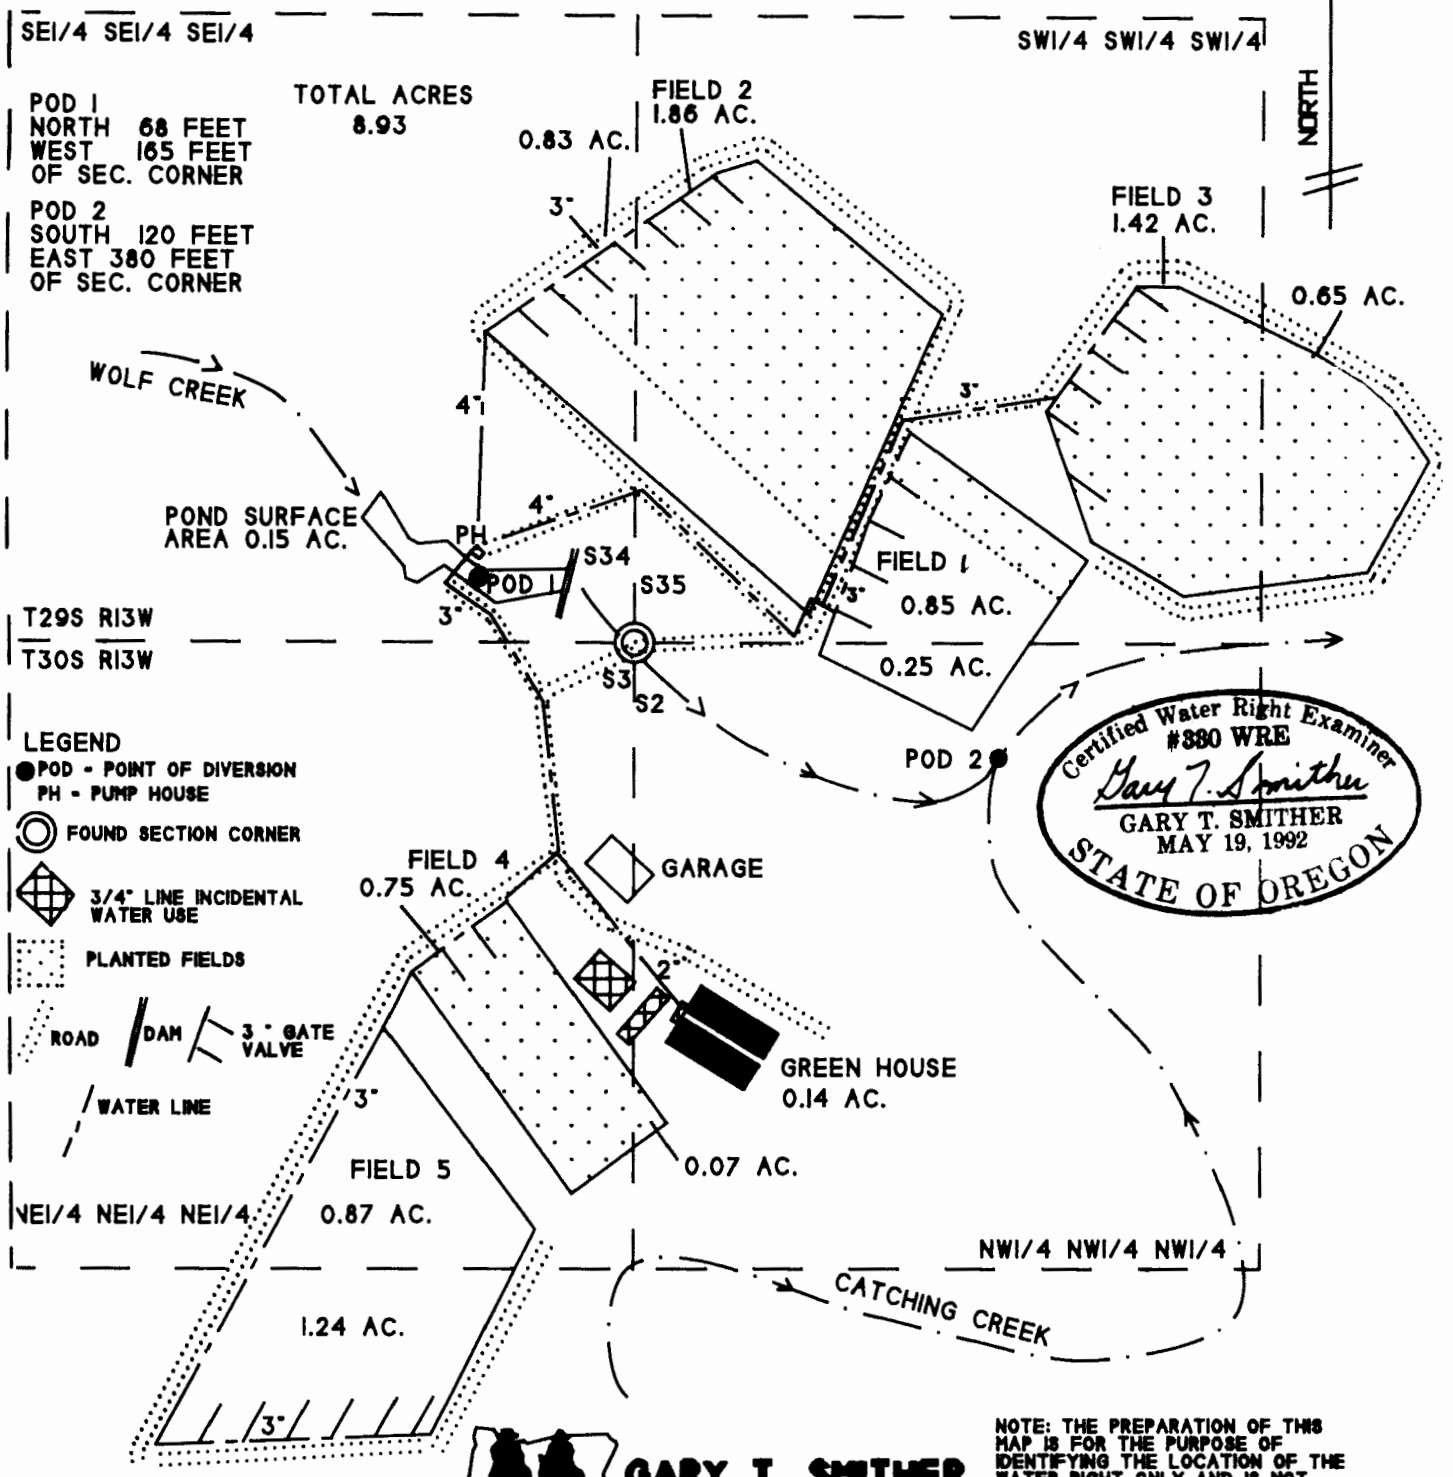

PREPARED FOR
MOORE MILL CO.
P.O. BOX 277
BANDON, OREGON 97411

GARY T. SMITHER
OREGON SURVEYOR
P.O. BOX 545, NORTH BEND, OREGON 97459
FAX & PHONE: (541) 751-9624

NOTE: THE PREPARATION OF THIS MAP IS FOR THE PURPOSE OF IDENTIFYING THE LOCATION OF THE WATER RIGHT ONLY AND IS NOT INTENDED TO PROVIDE DIMENSION OR LOCATION OF PROPERTY OWNERSHIP LINES.

RECEIVED
NOV 14 2000
WATER RESOURCES DEPT
SALEM, OREGON