

CLAIM OF BENEFICIAL USE


TRANSFER T-8935

IN THE NAME OF: DAY W. BODDORFF

Certificate 16390 - Additional Point of Diversion

TOWNSHIP 38 SOUTH, RANGE 3 WEST, W.M.

JACKSON COUNTY, OREGON

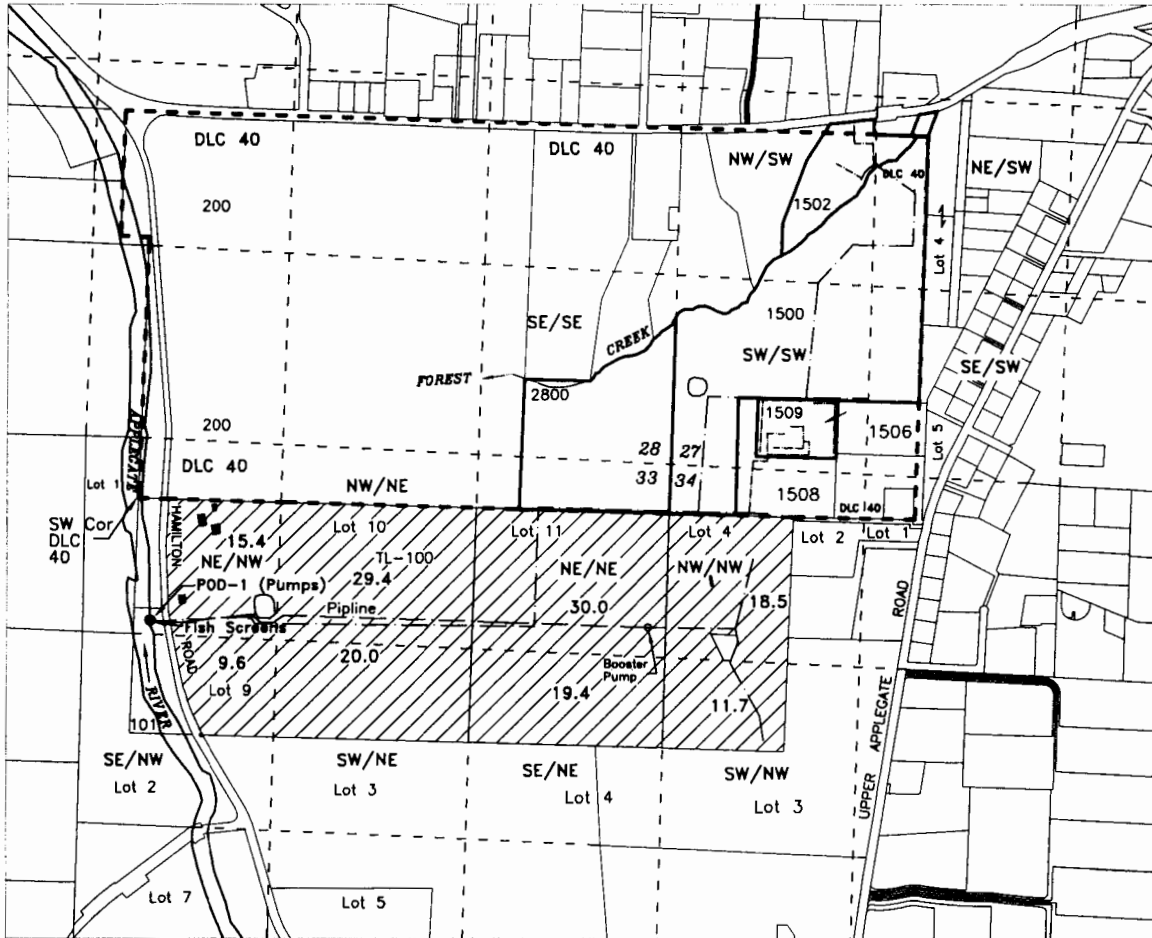

Scale

1" = 1320'


APOD - NE/NW, Lot 9, 820 feet South & 110 feet East from the SW corner of DLC 40, Section 33 Township 38S Range 3W, WM

Existing POD (of record) - ~~NW/NW~~ ^{NE/NE}, Section 14, Township 39 South, Range 3 West, W.M., 350 feet South & 900 feet East from the ~~NW~~ ^{NE} corner of Section ~~13~~ ¹⁴ per transfer application map



Place of Use 154 Acres - Irrigation & stock As re-described using new survey information & BLM cadastral survey data of surrounding area

NORTH

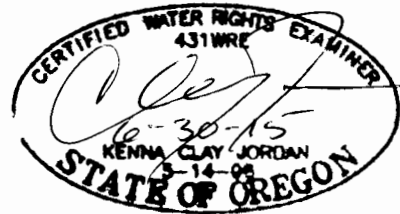

This map is not intended to provide legal dimensions or locations of property ownership lines

BASE MAP - Jackson County GIS & survey map CS-18687 oriented to GIS, over 2005 FSA & 8-23-2012 Google aerial photo overlay for assumed best fit

JORDAN ENGINEERING
460 JORDAN LANE
ROSEBURG, OR 97471
(541) 673-1931

Rev 9/22/2013 n.e.d.

Map revised by WRD to reflect correct location info. for Existing POD. MFG/WRD 10-20-15