

SCALE: 1"=1320'




Lands with primary rights from a well.

RECEIVED

MAR 05 2009

WATER RESOURCES DEPT
SALEM, OREGON

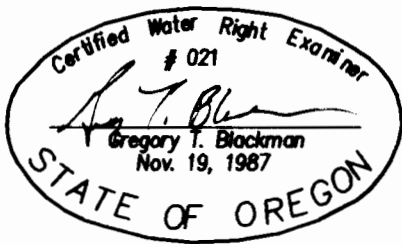

OCTOBER 13, 2008

**FINAL PROOF MAP OF
WATER RIGHTS FROM
A WELL**

FOR

SPECKHART FARMS INC.

BY

**BAGETT - GRIFFITH & BLACKMAN
2006 ADAMS AVENUE
LAGRANDE, OREGON 97850**

NOTE: The preparation of this map was for the purpose of identifying the location of the proposed water right and has no intent to provide dimensions or location of property ownership lines. Location information shown hereon was furnished by the applicant.

Application No. G- 16390

Permit Number G- 16023