


1 inch = 400 ft.

COBU MAP # 0300

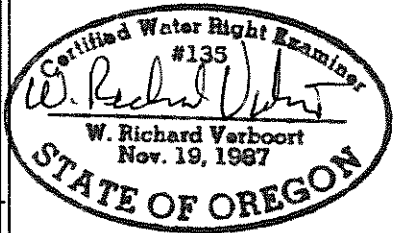

MAP IS BASED ON ASSESSORS
MAP, FSA PHOTO, & WRD
CERTIFICATE


FOR:
GLENN WALTERS NURSERY, INC.
P.O. BOX 280
BANKS, OR 97106

RECEIVED
SEP 17 2007
WATER RESOURCES DEPT
SALEM OREGON

FINAL PROOF SURVEY

LOCATED IN SECTIONS 7, & 18 T1N, R3W, WM.
WASHINGTON COUNTY, OREGON
UNDER APPLICATION S-84728, R-84729
PERMITS S-53788, R-13241
SURVEYED AUGUST 22, 2007

17 **Stuntzner**
Engineering
& Forestry, LLC
Project: 307-2-102
Drawing: 3072102
By: W.R. VERBOORT
Date: 8-28-2007

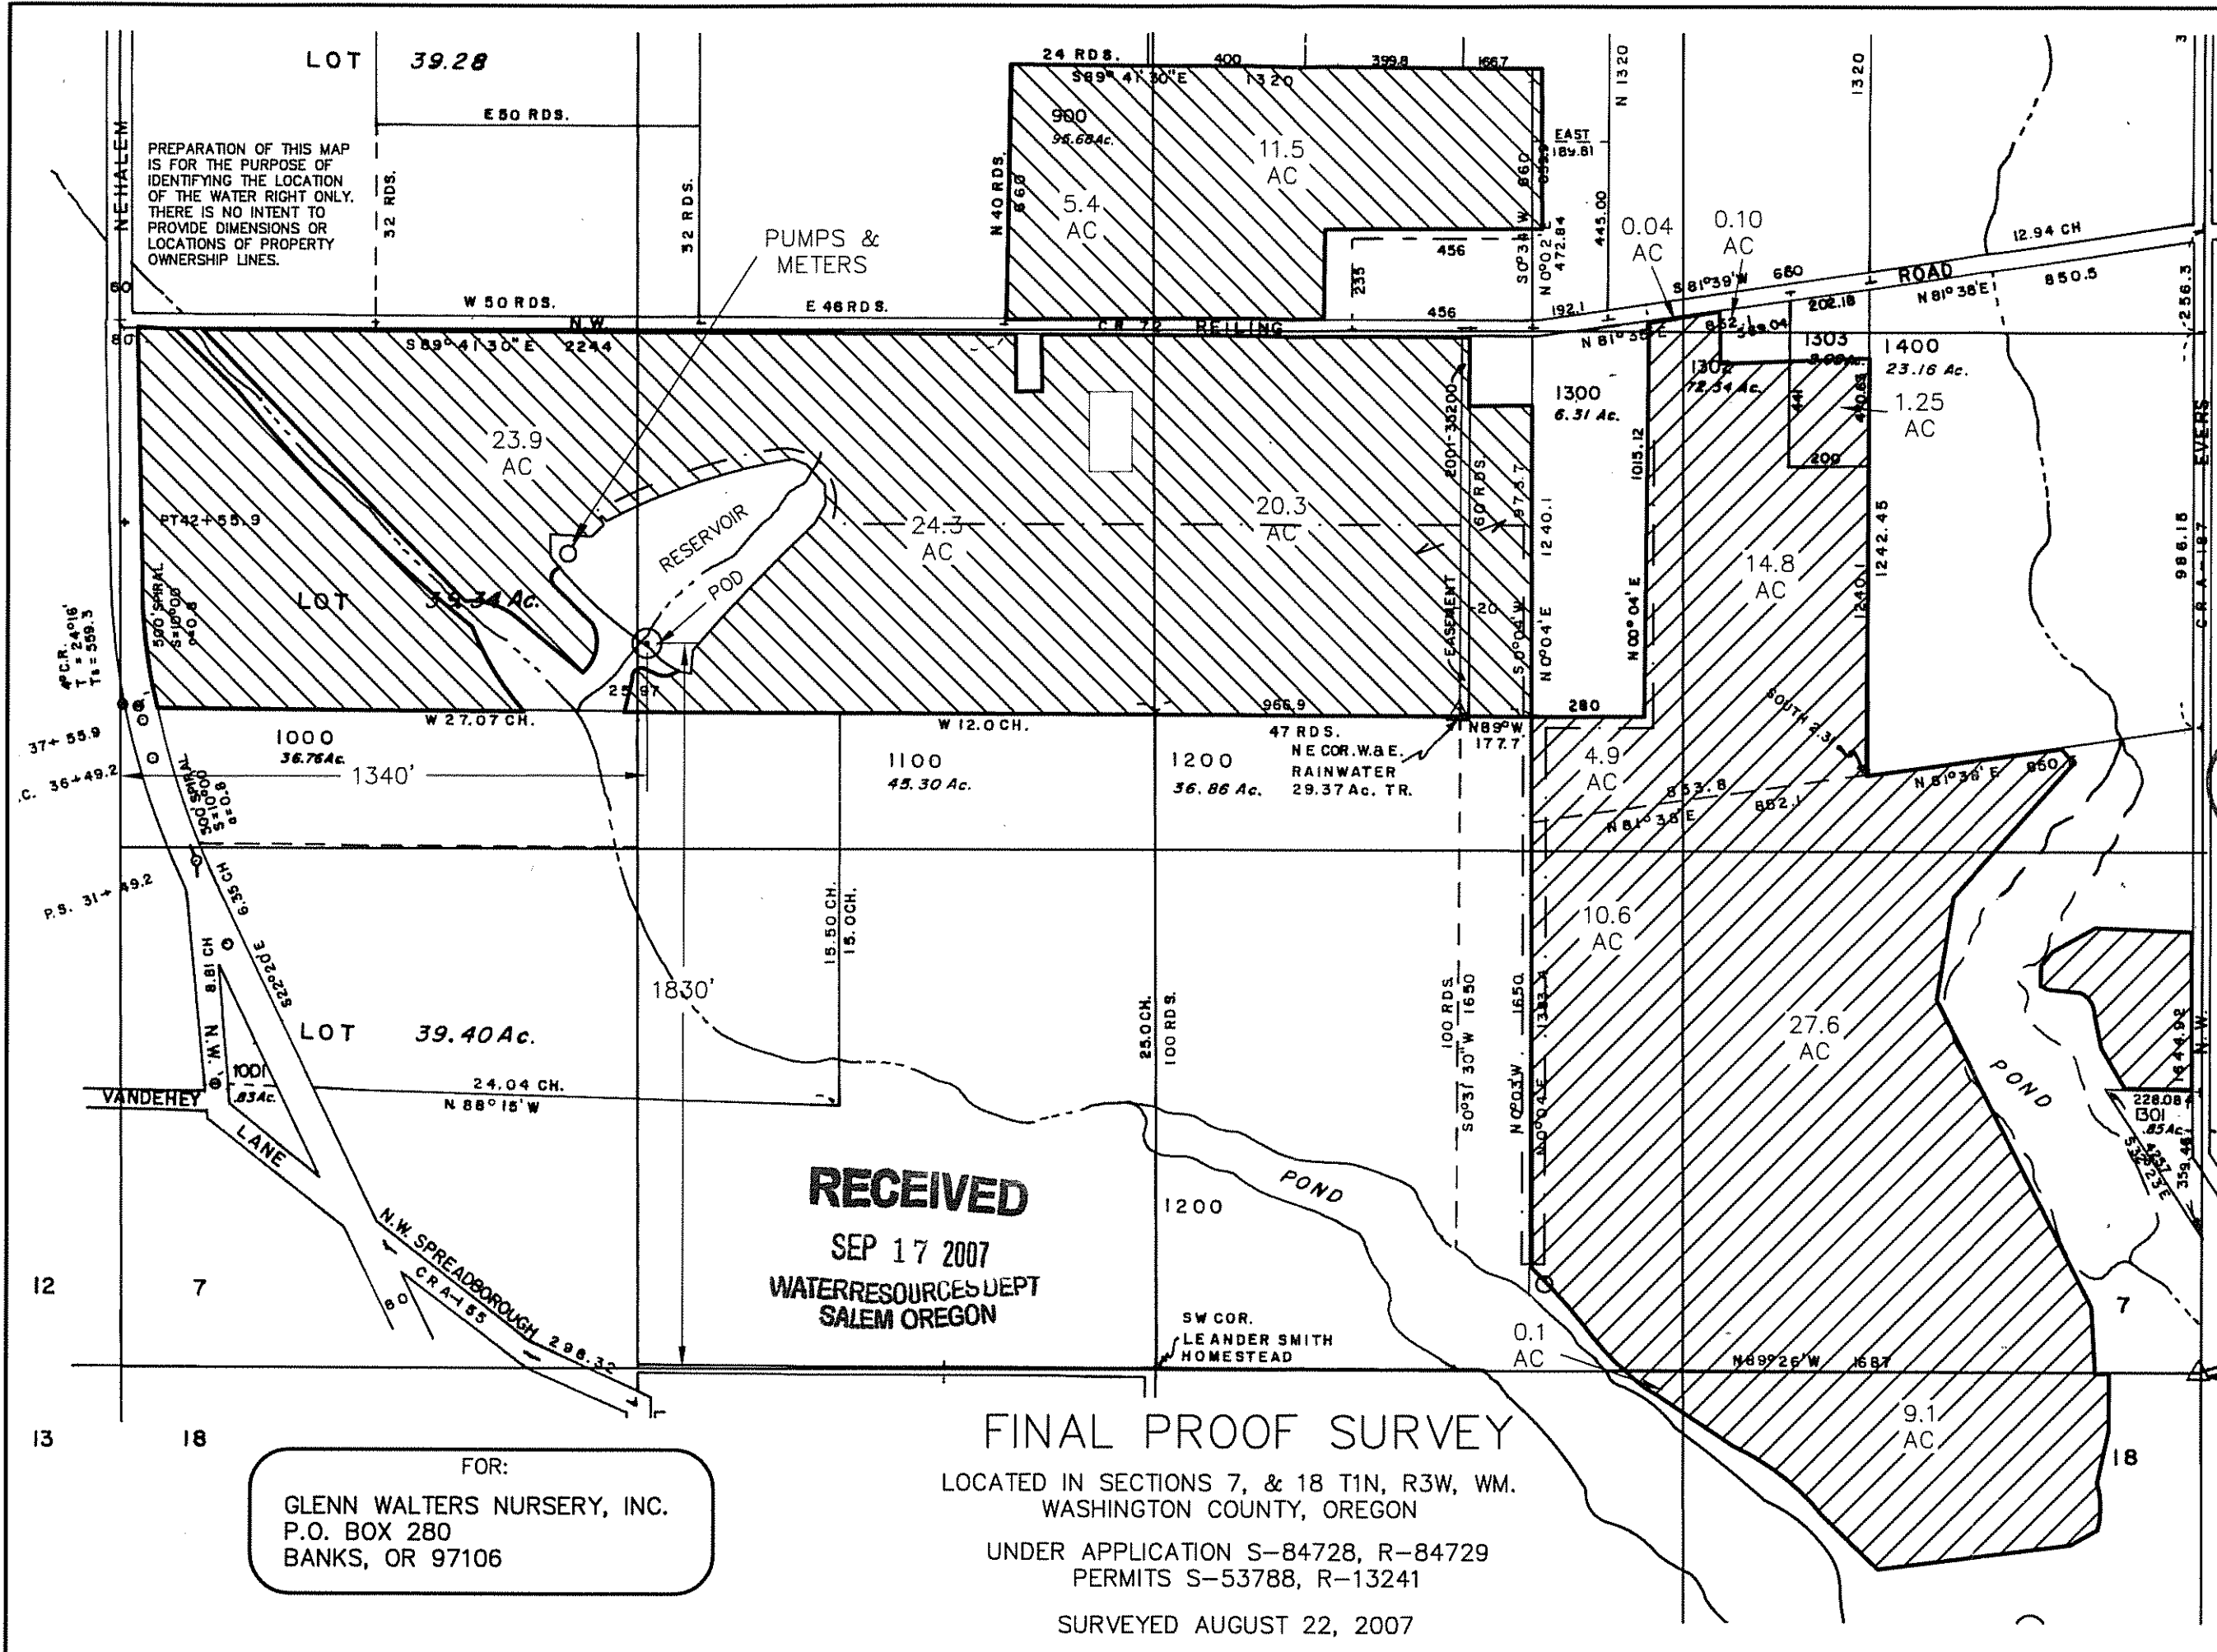

PREPARATION OF THIS MAP
IS FOR THE PURPOSE OF
IDENTIFYING THE LOCATION
OF THE WATER RIGHT ONLY.
THERE IS NO INTENT TO
PROVIDE DIMENSIONS OR
LOCATIONS OF PROPERTY
OWNERSHIP LINES.