

Claim of Beneficial Use Map
 Application #: G-16273 Permit #: G-15872
 In the Name of Phillip and Shannon Evonuk
 Property Described as Lane County Tax Lot 3102
 As Described on Map16-04-22-00
 DLC 46, Sections 22 & 27, T16S, R4W, W.M.

Well (W-1) and Flow Meter Location


Map Reference Point : Southwestern corner of Section 22, T16S, R4W, W.M.
 W-1 & Flow Meter: Located in the SW 1/4 SE 1/4 SW 1/4 of Section 22. It is 1,523 feet east, and 51 feet north from the map reference point.

Area Irrigated

The area irrigated is all within DLC 46 and Tax Lot 3102. Irrigated acreage by quarter-quarter section is: SE 1/4 SW 1/4 of Section 22 = 3.80 acres; SW 1/4 SW 1/4 of Section 22 = 9.77 acres; NE 1/4 NW 1/4 of Section 27 = 1.46 acres; NW 1/4 NW 1/4 of Section 27 = 3.50 acres - Total Acres Irrigated = 18.53 acres

Disclaimer: This map is not intended to provide legal dimensions or location of property ownership lines.

Note: No permanent conveyance structures are used in the system, therefore none are illustrated on this map.

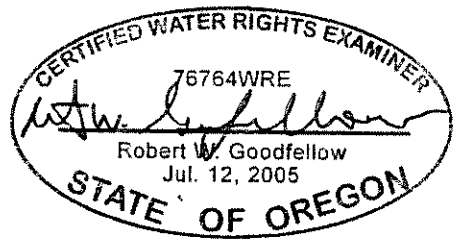

Expires: June 30, 2009

Key
 Scale: 1 inch = 400 feet

1/4 1/4 Section Line:

DLC 46 Boundary Line:

Note: Eastern and Southern line not shown; all of Tax Lot 3102 is within DLC 46. Verbally verified by the Lane County Surveyor's Office.

Area Irrigated:

Well W-1 and Meter:

Map Source: Lane County Tax Assessor

SEE MAP 16 04 21 00

SEE MAP 16 04 27 00