


**COBU MAP #**  
**0300**

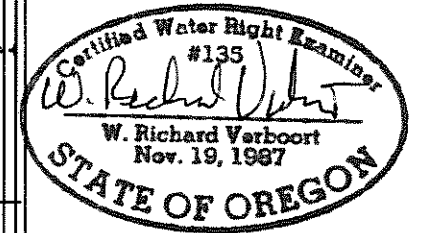

MAP IS BASED ON ASSESSORS  
MAP, FSA PHOTO, & WRD  
CERTIFICATE

FOR:  
GLENN WALTERS NURSERY, INC.  
P.O. BOX 280  
BANKS, OR 97106

**RECEIVED**  
SEP 17 2007  
WATER RESOURCES DEPT  
SALEM OREGON

**FINAL PROOF SURVEY**  
LOCATED IN SECTIONS 7, & 18 T1N, R3W, WM.  
WASHINGTON COUNTY, OREGON  
UNDER APPLICATION S-84728, R-84729  
PERMITS S-53788, R-13241  
SURVEYED AUGUST 22, 2007

**Stuntzner**  
Engineering  
& Forestry, LLC  
Project: 307-2-102  
Drawing: 3072102  
By: W.R. VERBOORT  
Date: 8-28-2007

