


# T. 7 S., R. 39 E., W.M.

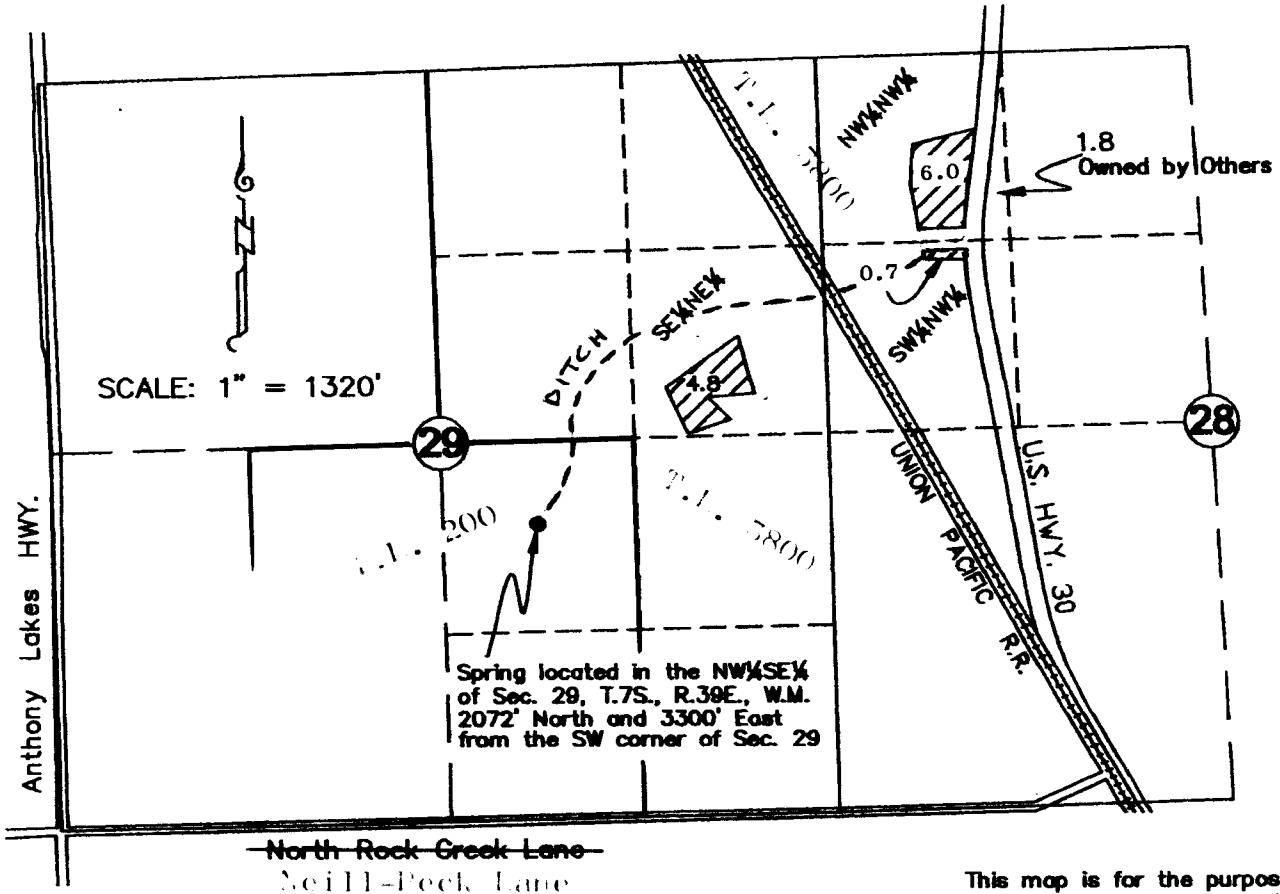


This map is for the purpose of identifying the water right location only and is not intended to provide legal dimensions or location of property ownership lines.

## CLAIM OF BENEFICIAL USE MAP FOR TRANSFER OF WATER USE FROM STOCK TO SUPPLEMENTAL IRRIGATION In Name of James Ingram Application T-6882 Amended October, 2003

SITE SURVEY: Aug. 28, 2008

### LEGEND

 Lands irrigated from spring, supplemental

RECEIVED

FEB 17 2009

RECEIVED  
SEP 2008  
WATER RESOURCES DEPT  
SALEM, OREGON

WATER RESOURCES DEPT  
SALEM, OREGON

HANLEY ENGINEERING, INC.  
2043 MAIN STREET  
BAKER CITY, OREGON

Revised on 2-12-2009 to show tax lot #'s & corrected road name

