

CLAIM OF BENEFICIAL USE MAP

Association of Unit Owners of the Quintet Condominiums


Application: R-73760 Permit: R-12792

Application: S-73761 Permit: S-53660


Township 1 South, Range 1 West, W.M., Section 1
Washington County, OR

Tax Lot 80000

36 31
1 6

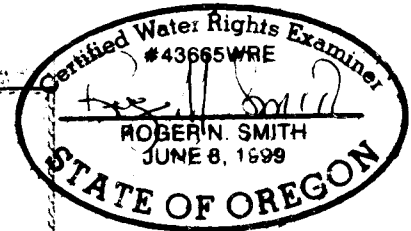

EXPIRATION DATE 6/30/10

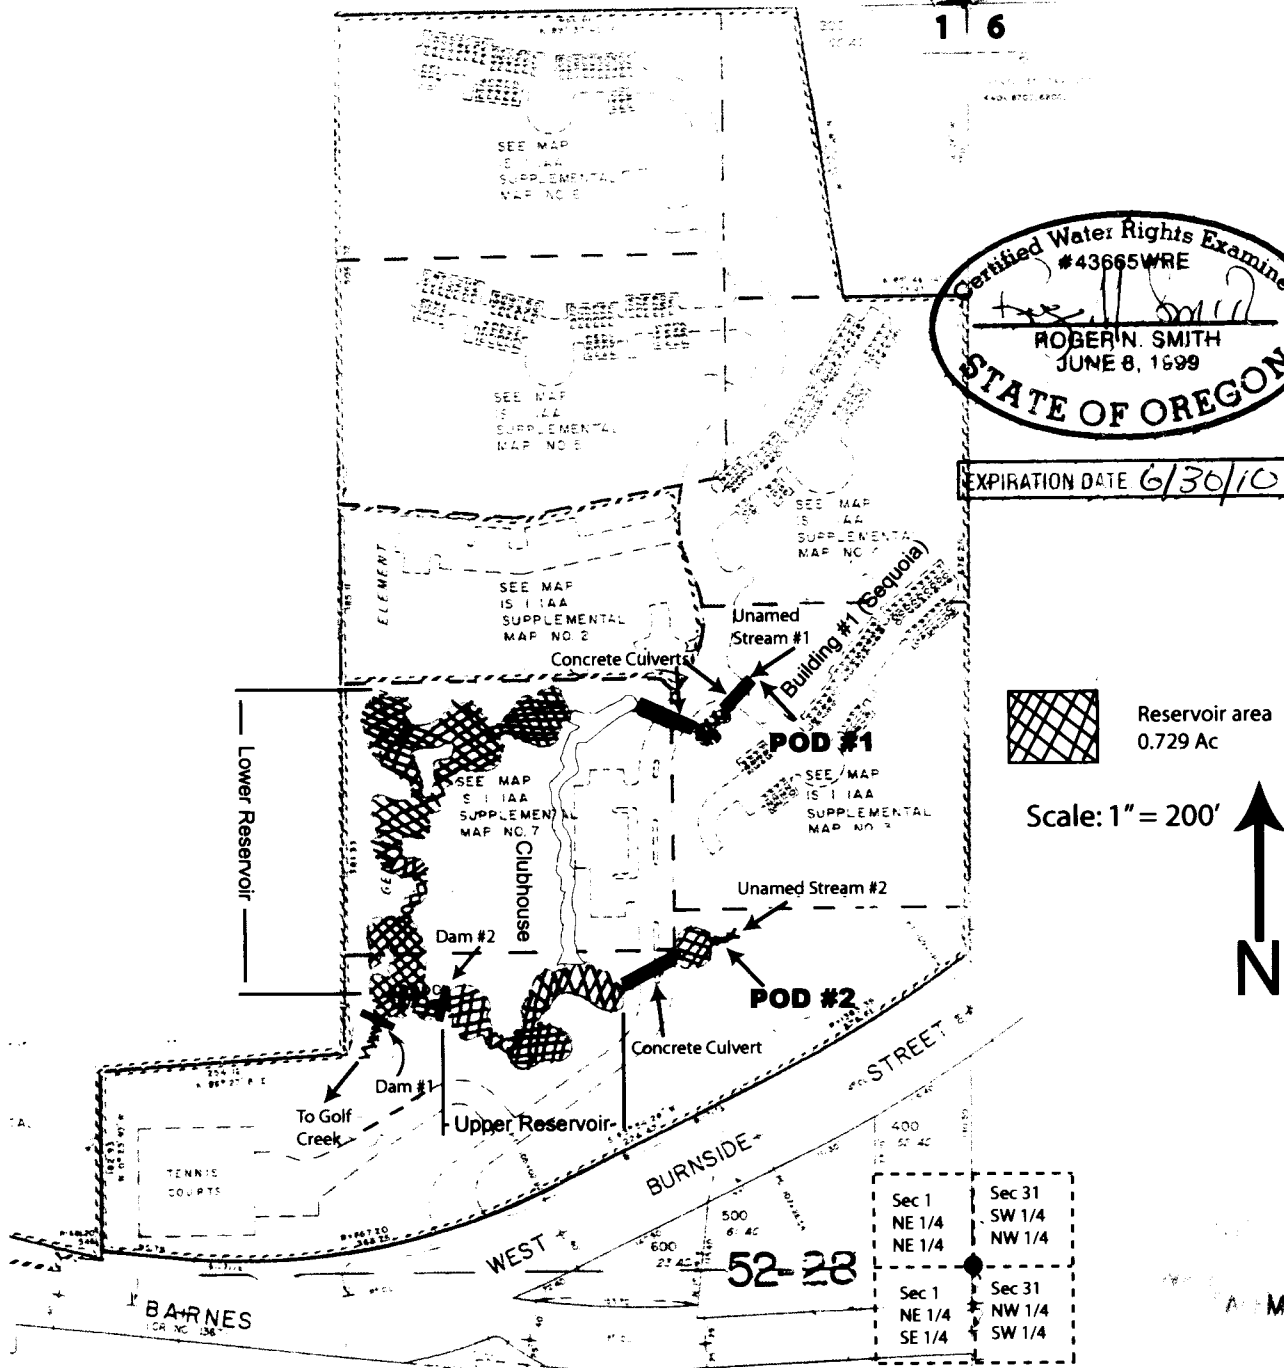

Points of Diversion Locations:

Unnamed Stream #1; 700 feet south and 220 feet west of the NE corner Section 1 (W.M.)

Unnamed Stream #2; 964 feet south and 224 feet west of the NE corner Section 1 (W.M.)

Dam Locations:

Dam #1; 1,060 feet south and 610 feet west of the NE corner Section 1 (W.M.)

Dam #2; 1,047 feet south and 550 feet west of the NE corner Section 1 (W.M.)

This map is not intended to provide legal dimension or locations of property ownership lines.