
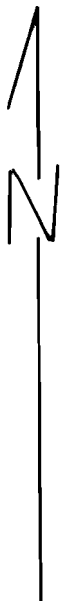


RECEIVED

Township 13 South, Range 30 East, W.M.

MAY 18 2008

WATER RESOURCES DEPT.
SALEM, OREGON

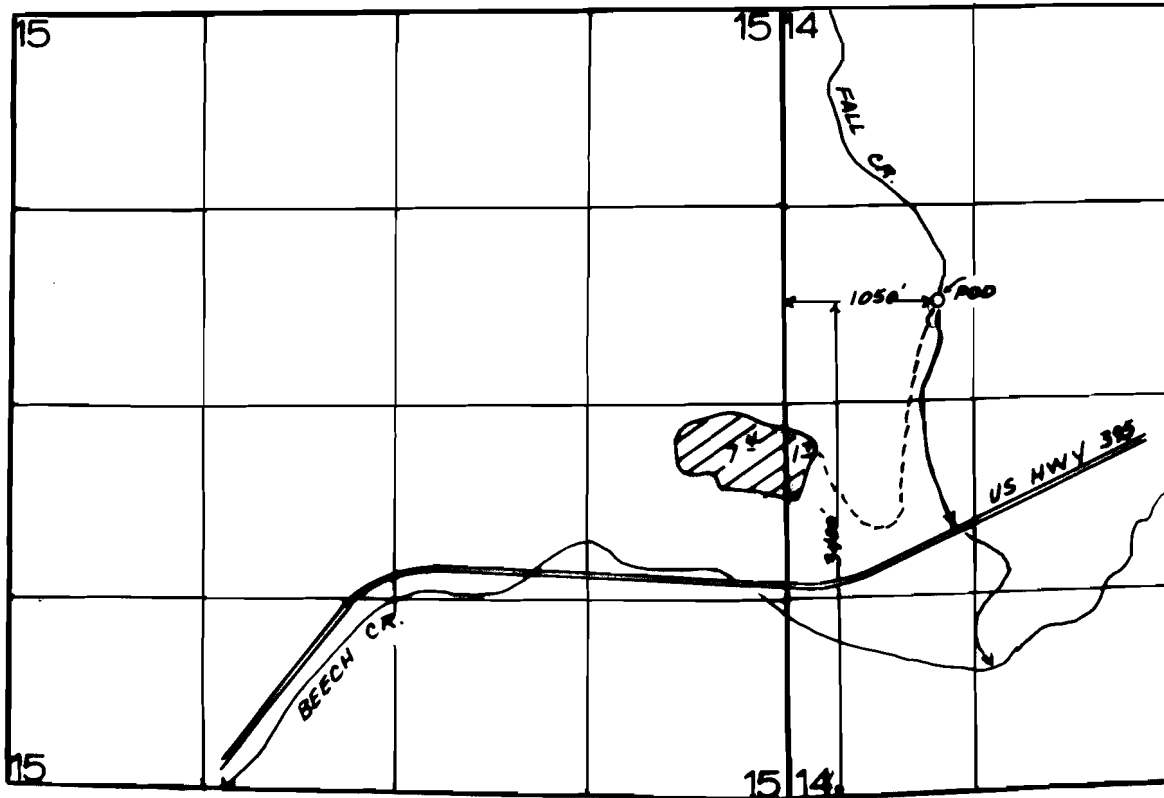

FINAL PROOF SURVEY
UNDER

Application No. .67920. Permit No. .68299.....
IN NAME OF

.....ROY..KILPATRICK.....

Surveyed .SEPT..16 1998., by .J..MILLER.....

1" = 1320'