

689



T3S, R2E, Section 21, WM Claim of Beneficial Use Map Clackamas County

Permit No. G-13947 Application No. G-15189

THIS MAP IS NOT INTENDED TO
PROVIDE LEGAL DIMENSIONS
OR LOCATIONS OF PROPERTY
OWNERSHIP LINES.

Map Date: November 29, 2011

Site Inspection of Well and
Irrigated Areas Conducted
August 13, 2009
December 17, 2009, and
September 27, 2011

 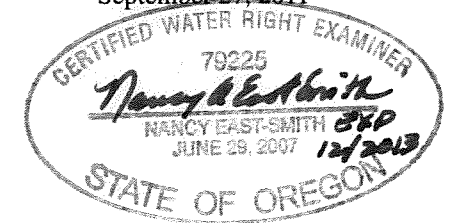

1 inch = 400 feet

FIGURE 1

STONE CREEK GOLF CLUB



- Well 1/ Well B
- Mainline
- Place of Use for Supplemental Irrigation (109.7 Acres)
- Place of Use for Reservoir and Maintenance (Recreation)

Well 1/ Well B (CLAC 56352) located South 21° West 1,305 feet (1,240 ft S and 430 ft W from N¼ corner of Section 21)

COBU MAP # 689