


# FINAL PROOF SURVEY MAP

IN THE NAME OF ROBERT & PHYLLIS PRICHARD

Application S-81246, Permit 53424


T 9 S, R 1 E, W.M.  
Section 15 & 22

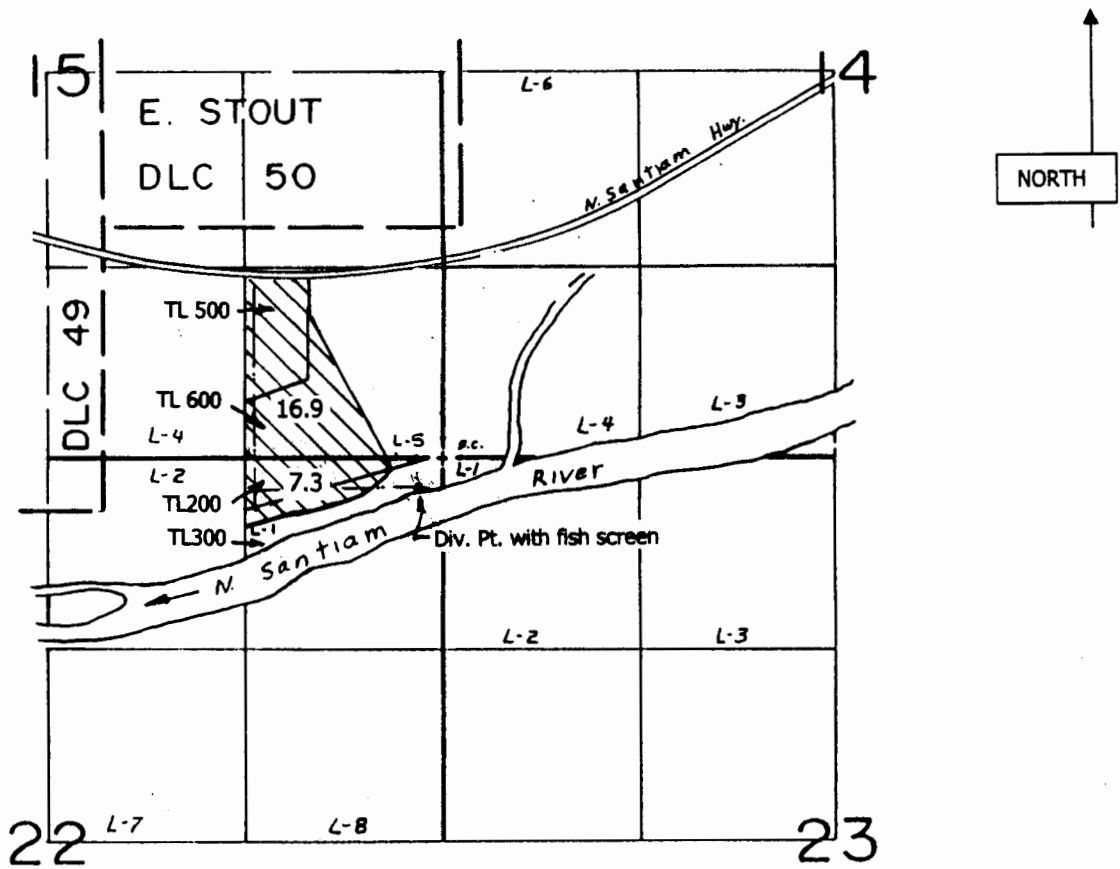

North Santiam River Div. Pt.: 200' S and 150' W of the NE corner section 22

Scale 1" = 1320'

This map is not intended to provide legal dimensions or locations of property ownership lines.

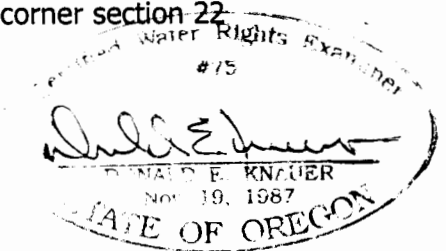

DATE 6/30/2009