



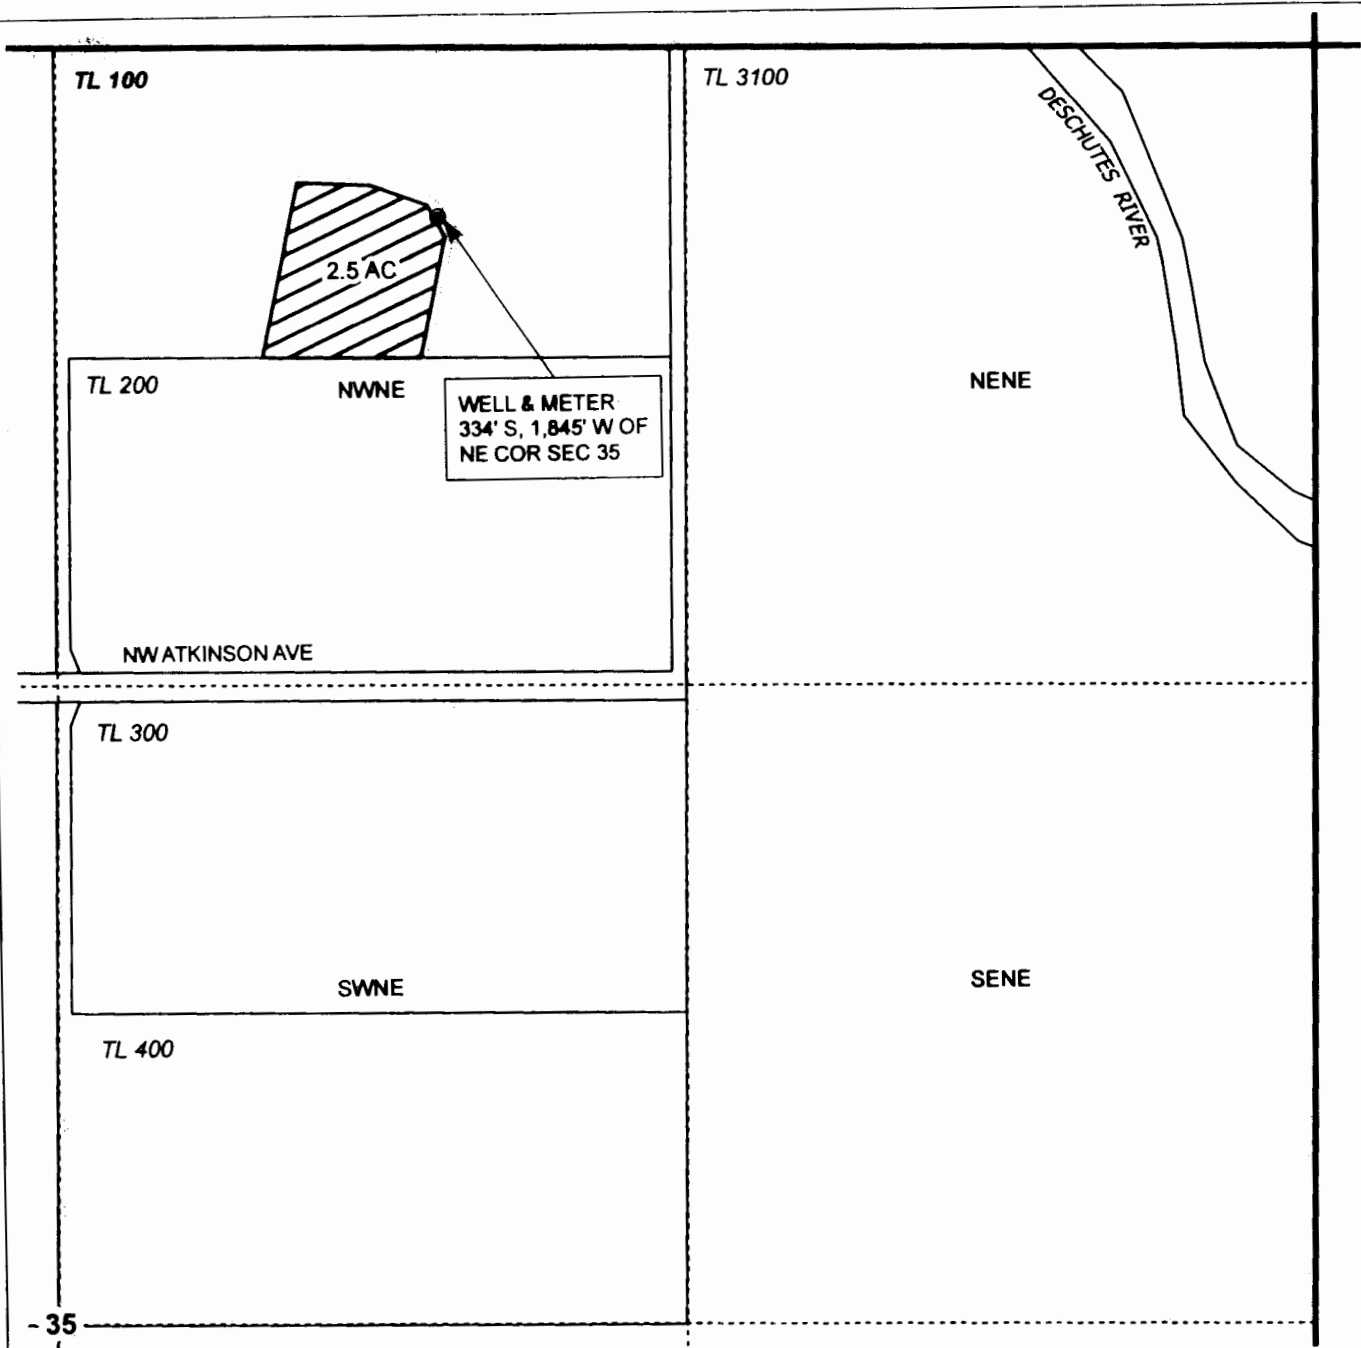


**T14S, R12E,  
SECTION 35, WM**

**DESCHUTES COUNTY, OREGON**

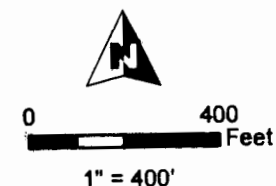

- POU Irrigation
- Section
- Quarter Quarter
- Taxlot
- Well

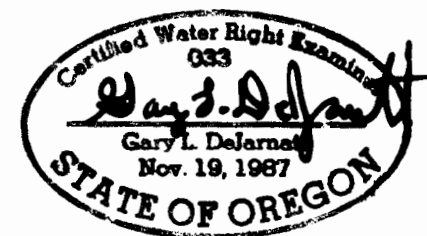

RENEWAL DATE 12/31/2015

**CLAIM OF BENEFICIAL USE MAP**  
**George Boehlert**

Application G-17292 Permit G-16773

NOTE: THIS MAP IS NOT INTENDED TO  
PROVIDE LEGAL DIMENSIONS OR LOCATIONS  
OF PROPERTY OWNERSHIP LINES.

PROJECT #15038

JUNE 29, 2015

**WATER RIGHT SERVICES, LLC**  
PO BOX 1830, BEND, OR 97709  
CCB# 197121 [www.oregonwater.us](http://www.oregonwater.us)  
541-389-2837 [JOHNSHQT@USA.COM](mailto:JOHNSHQT@USA.COM)