


T.25 S., R.34 E., W.M.

HARNEY CO., OR.

**RECEIVED**

MAR 26 1997

WATER RESOURCES DEPT.  
SALEM, OREGON

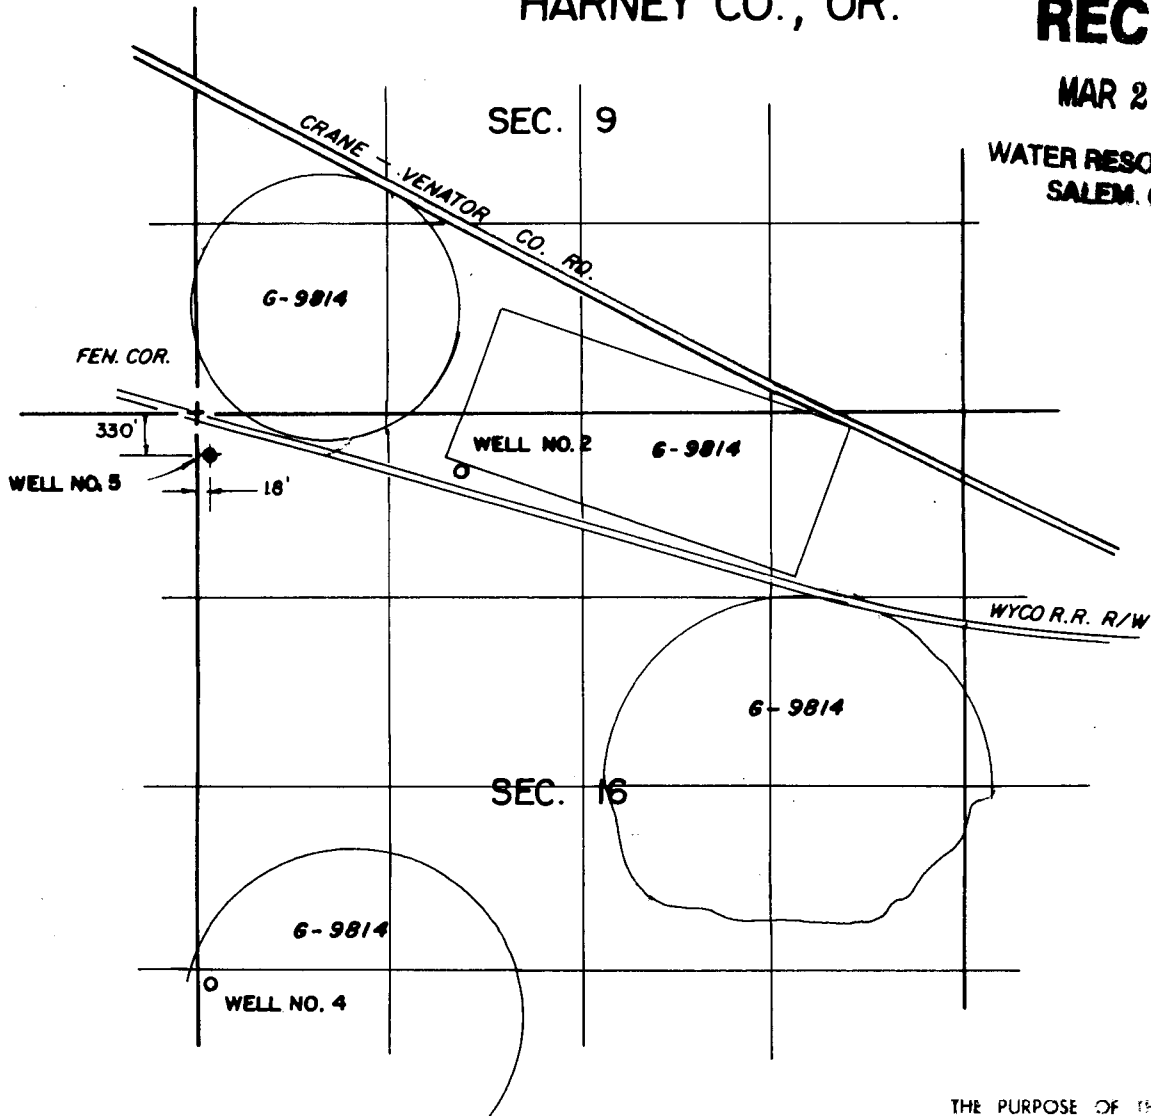

THE PURPOSE OF THIS MAP IS TO  
IDENTIFY THE LOCATION OF THE  
WATER RIGHT. IT IS NOT INTENDED  
TO PROVIDE INFORMATION RELATIVE  
TO THE LOCATION OF PROPERTY  
OWNERSHIP

CANEVARI TIMBER CO., INC.

FORTUNA, CA.

**FINAL PROOF SURVEY**

UNDER

TRANSFER NO. T-7129

Scale: 1" = 1320'

Date: JAN. 14, 1997

Job: 1289

Dsn: -

Drn: CORK

Ckd: -

**MAP's**

M. A. PALMER & SONS, INC.  
ENGINEERING & SURVEYING  
254 N. Alder - Box 61  
Burns, Oregon 97720

Sht. No.

of 1

