


T. 4 S., R. 2 W., W.M.

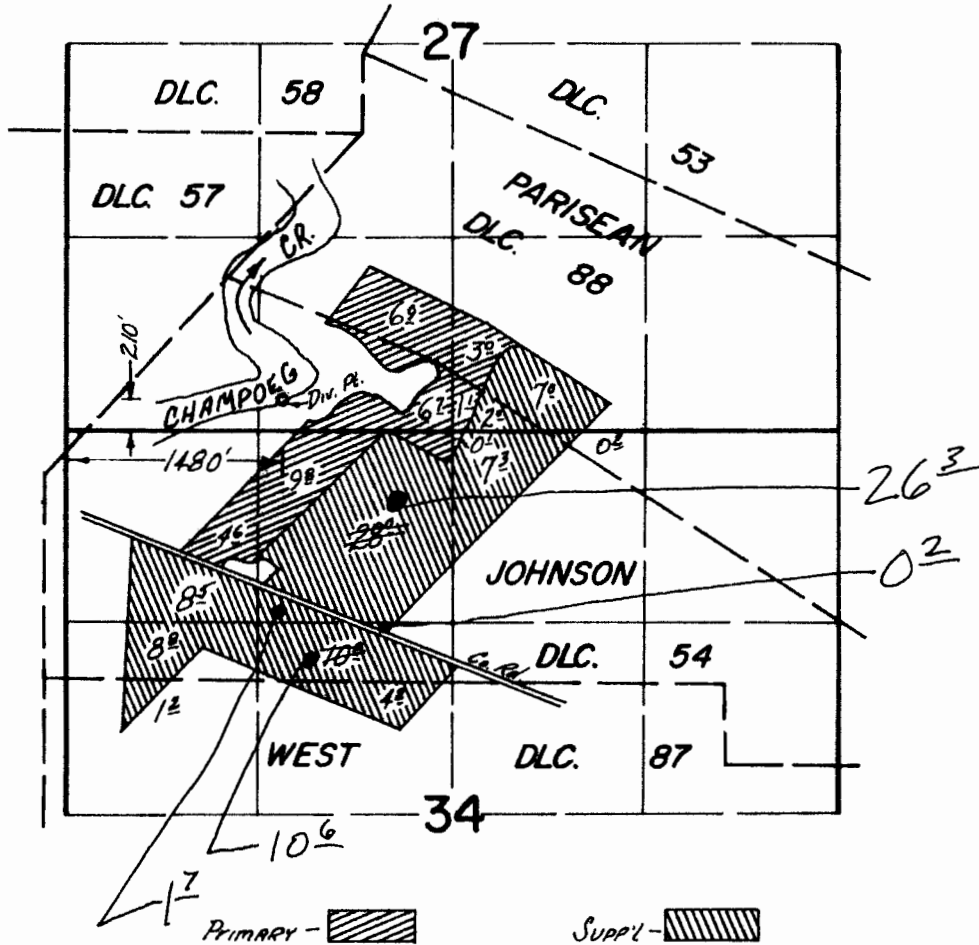

FINAL PROOF SURVEY
UNDER

Application No. 44513 Permit No. 32873
IN NAME OF

PATRICK J. JOHNSTON

Surveyed MAY 23 1973, by T. PAUL

Acreages adjusted using application map for Permit G-16786 dated 9/8/2004
Map updated by WRD on 11/5/2015 JC