
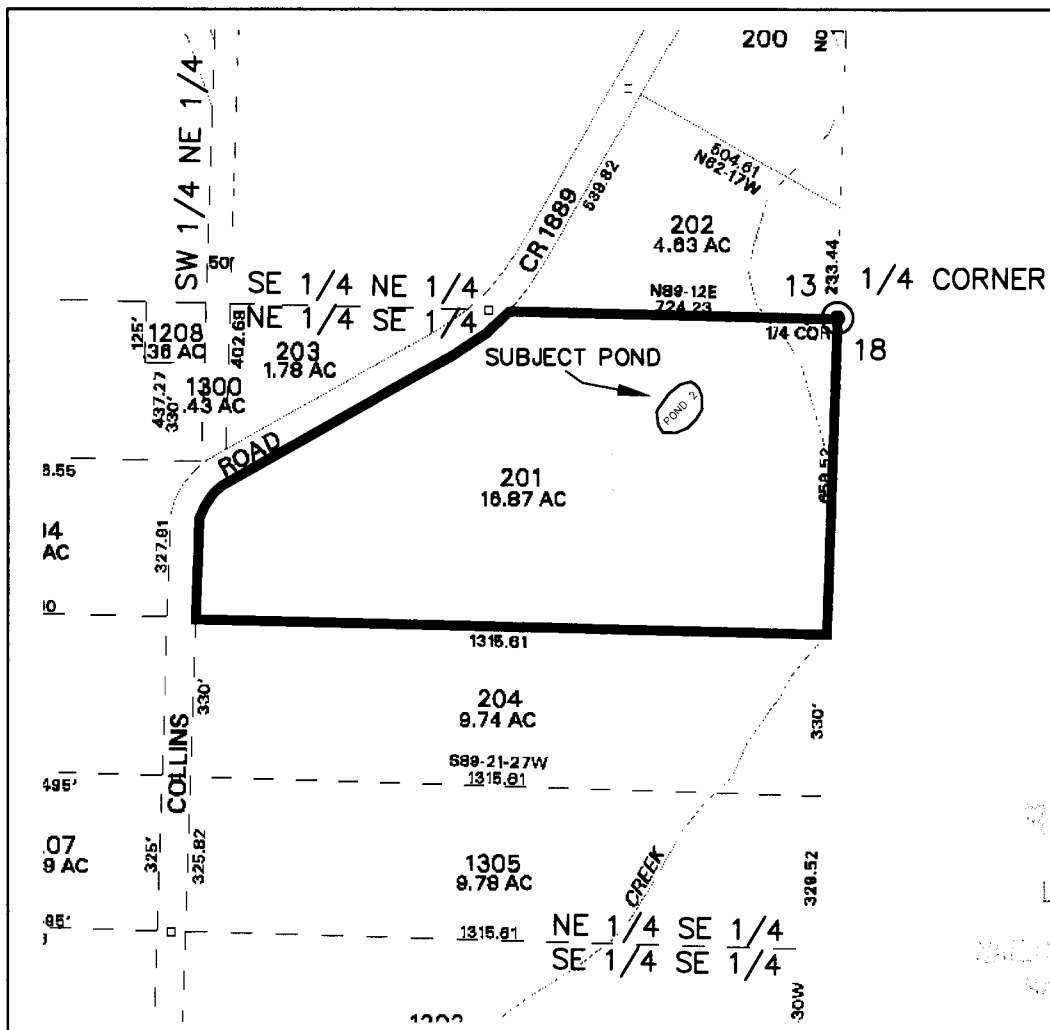


CLAIM OF BENEFICIAL USE MAP FOR BAMBOO GARDENS

LOCATED IN THE NE 1/4 OF THE SE 1/4 OF SECTION 13, TOWNSHIP 2 NORTH,
RANGE 3 WEST, WILLAMETTE MERIDIAN.
WASHINGTON COUNTY, OREGON


APPLICATION #R-84740

PERMIT#R-13078

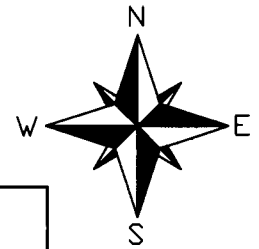

● GOVERNMENT CORNER

PREPARED FOR:
NED JAQUITH
18900 NW COLLINS RD.
NORTH PLAINS, OR 97133

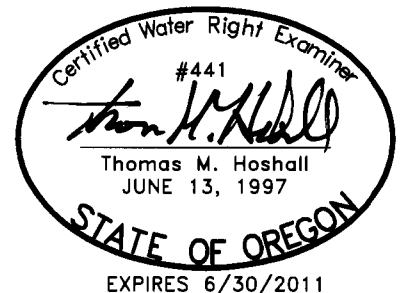

THIS MAP WAS PREPARED FOR THE PURPOSE OF
IDENTIFYING THE LOCATION OF A WATER RIGHT ONLY AND
IS NOT INTENDED TO PROVIDE LEGAL DIMENSIONS OR
LOCATION OF PROPERTY OWNERSHIP LINES.

400 0 200 400



1 inch = 400 ft.

MAP BASE:
WASHINGTON COUNTY TAX MAP
SECTION 13, T2N, R3W



PROJECT: 310-2-047 PH.200
DRAWING: 3102047B.dwg
DRAWN BY: JMH
CHECKED BY: TMH
DATE: 8-3-2010