


T 6 S, R 1 W, W.M.

MARION COUNTY, OREGON

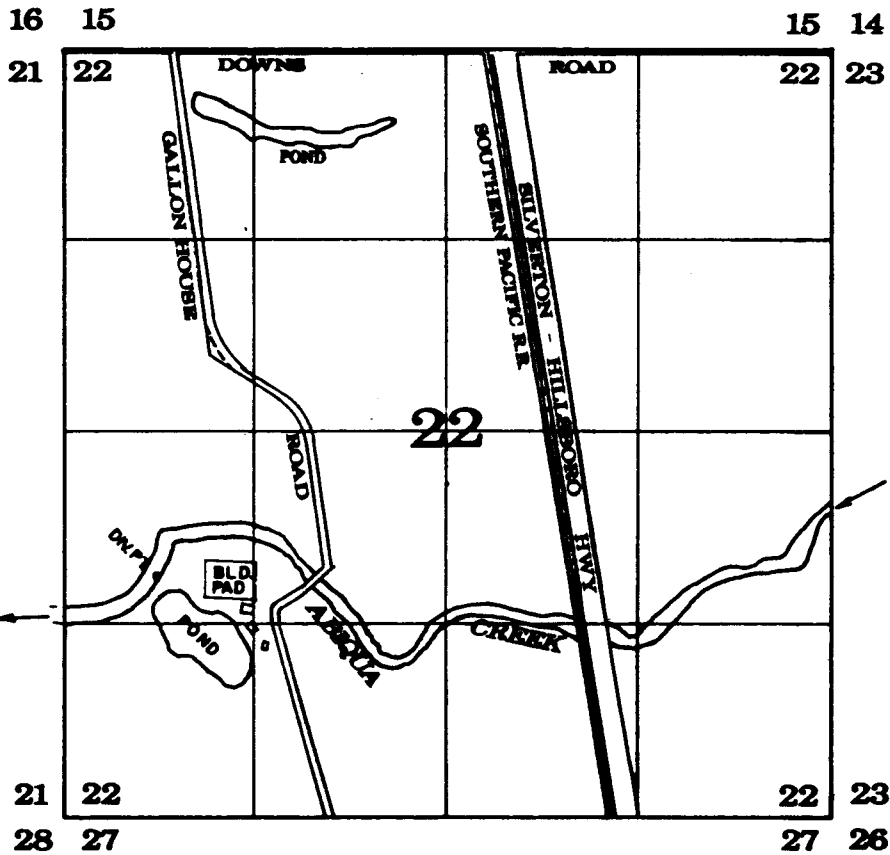

DIV. PT. 580'E & 1585'N FROM THE SW CORNER OF SEC 22 T.6S, R.1W, W.M.
 CENTER OF POND 940'E & 1270'N FROM THE SW CORNER OF SEC 22
 T.6S., R.1W., W.M.


FINAL PROOF SURVEY

33615 26580
 Application No. S 72222 Permit No. 51992

FRED RHYME

Scale 1" = 1320'

SEPTEMBER 22, 1999

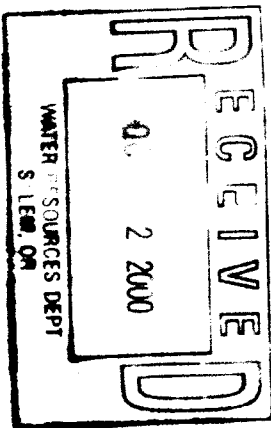

NOTE: This map is for the purpose of identifying the location of water rights and has no intent to dimension or locate property ownership lines.

