



**T14S, R12E,
SECTION 35, WM**


DESCHUTES COUNTY, OREGON

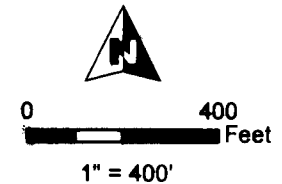

-  POU Irrigation
-  Section
-  Quarter Quarter
-  Taxlot
-  Well

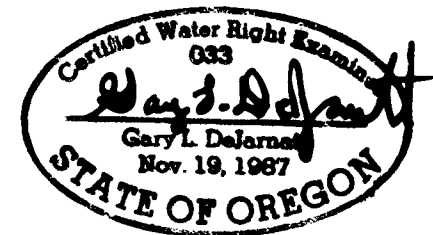

RENEWAL DATE 12/31/2015

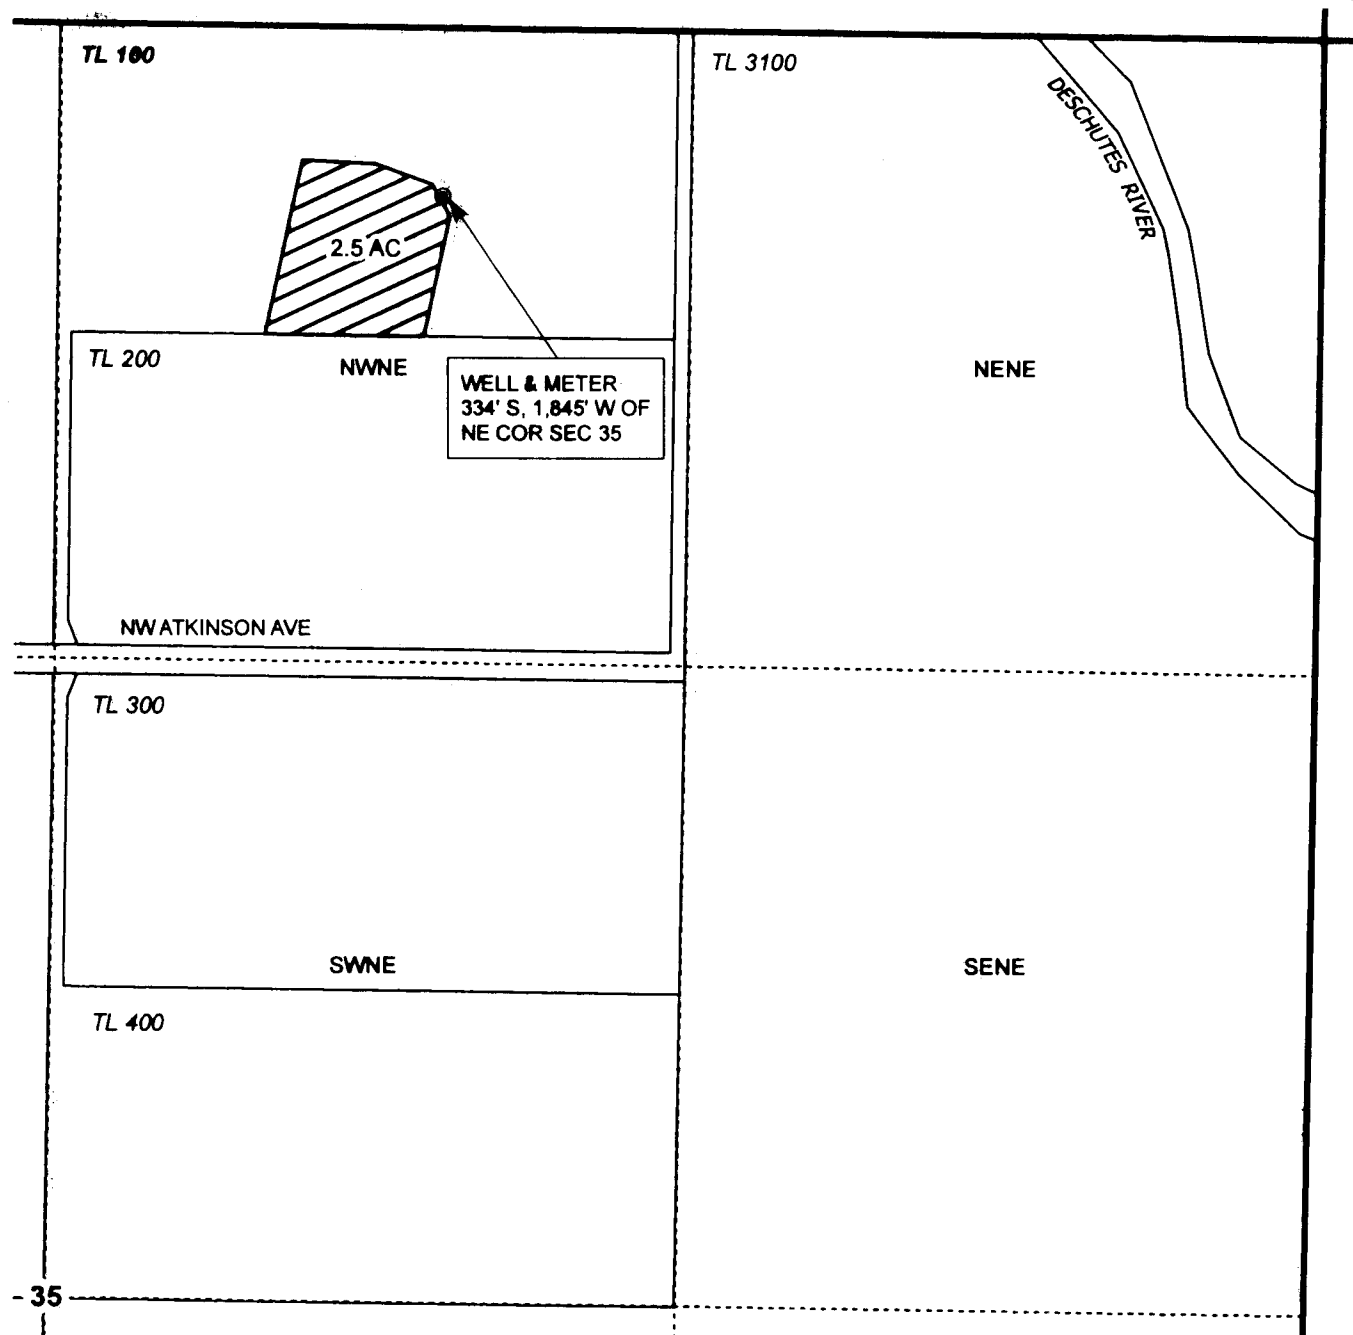

CLAIM OF BENEFICIAL USE MAP
George Boehlert

Application G-17292 Permit G-16773

NOTE: THIS MAP IS NOT INTENDED TO
PROVIDE LEGAL DIMENSIONS OR LOCATIONS
OF PROPERTY OWNERSHIP LINES.

PROJECT #15038

JUNE 29, 2015

WATER RIGHT SERVICES, LLC
PO BOX 1830, BEND, OR 97709
CCB# 197121 www.oregonwater.us
541-389-2837 JOHNSHORT@USA.COM