



T.35S.,R.1W.,W.M.

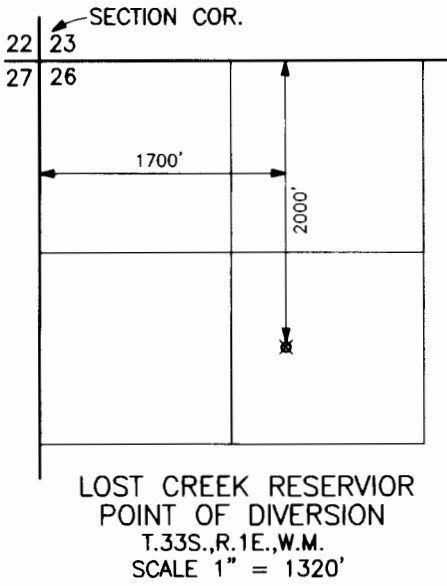

SCALE 1" = 400'

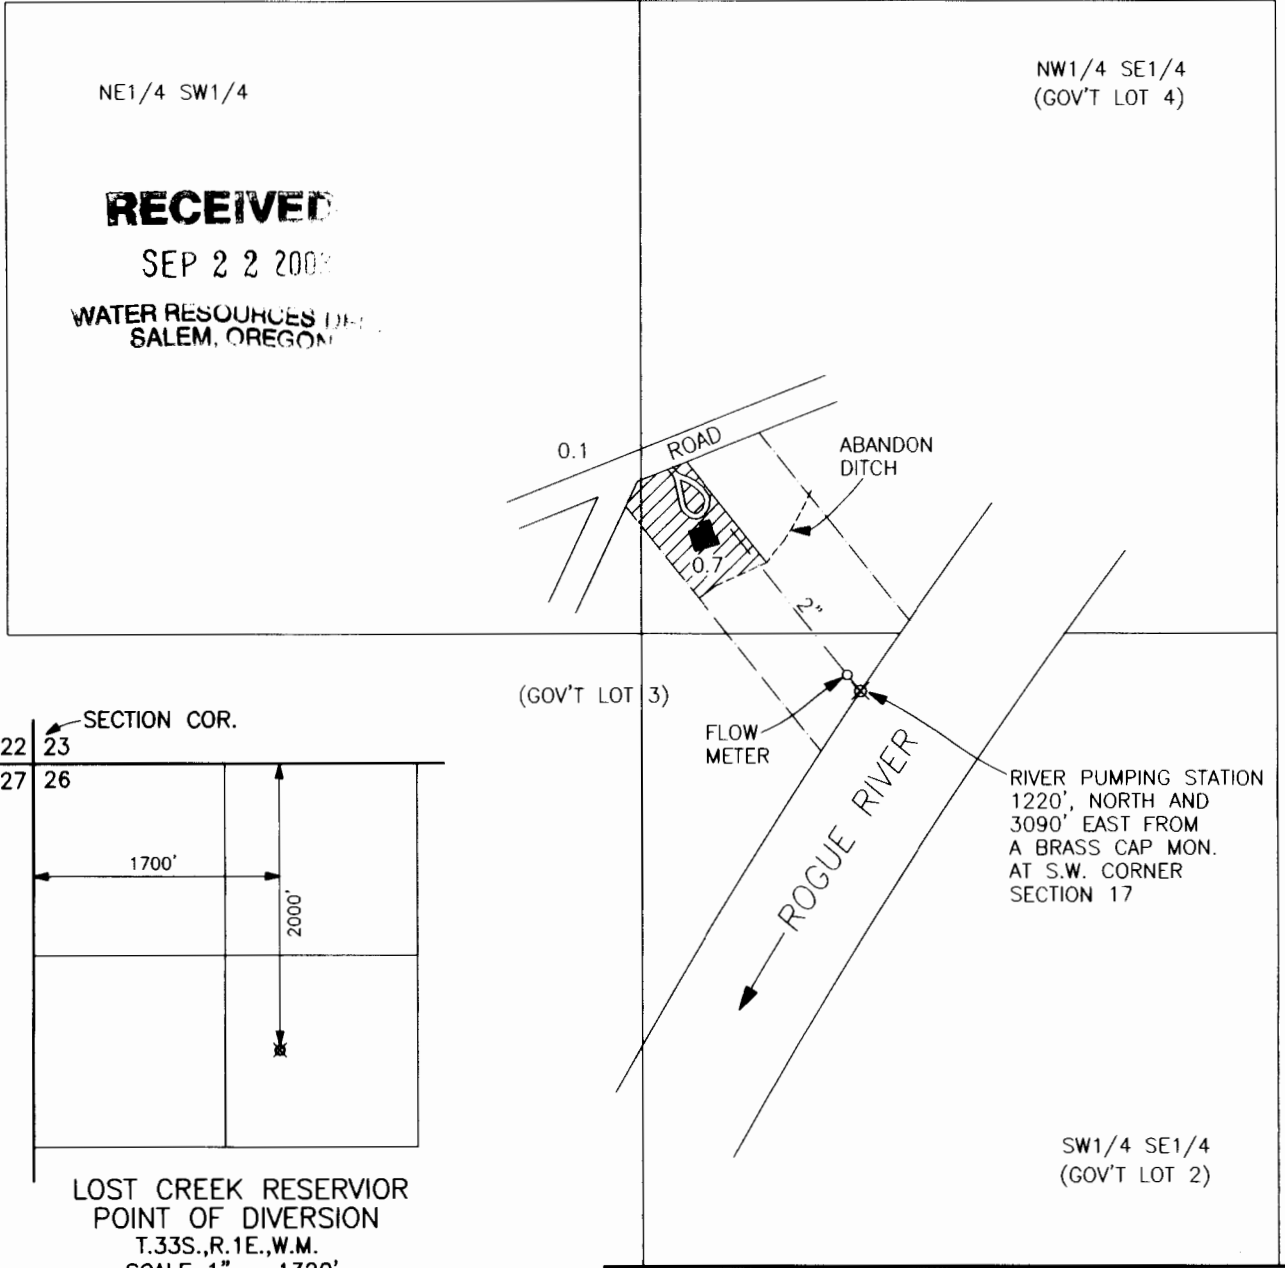

CLAIM OF BENEFICIAL USE MAP

APPLICATION No. S-81663
PERMIT No. 53371

IN THE NAME OF
RALPH D. WORTHYLAKE

MAP PREPARED SEPTEMBER 2, 2003 BY GARY D. KAISER

NOTE: MAP PREPARED FOR
WATER RIGHT PURPOSES ONLY,
NOT FOR PROPERTY BOUNDARY
LOCATIONS.

