


FINAL PROOF SURVEY

SCALE: 1"=400'

T.2N., R5W., W.M.

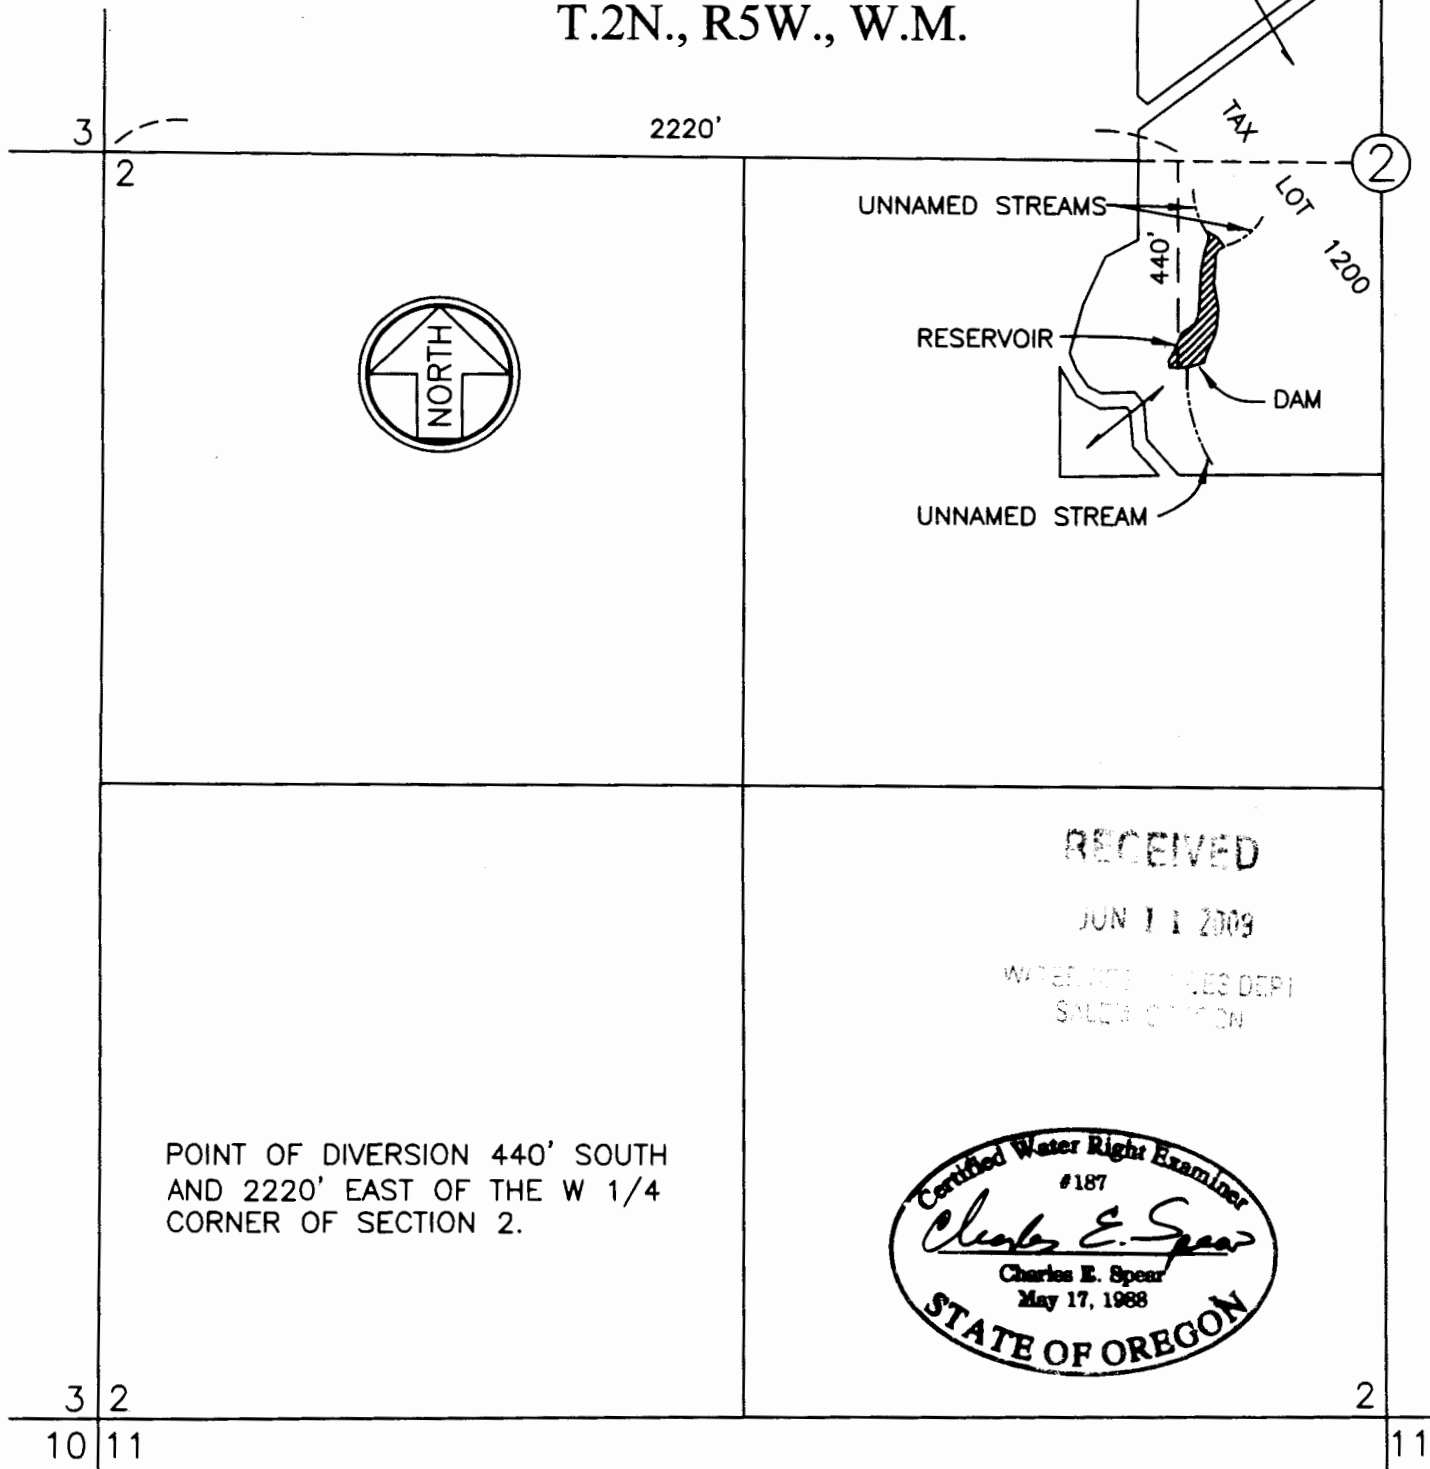

PREPARED BY:

SPEAR SURVEYING SERVICES
947 NE BIRCHAIRE LN.
HILLSBORO, OR 97124
(503) 648-2879

Under Application No.: R-74287 Permit No.: R-11719
IN NAME OF: Forever Green Forests C/O Jack N. Seabold
Surveyed: April 1, 2009