


Claim of Beneficial Use Map

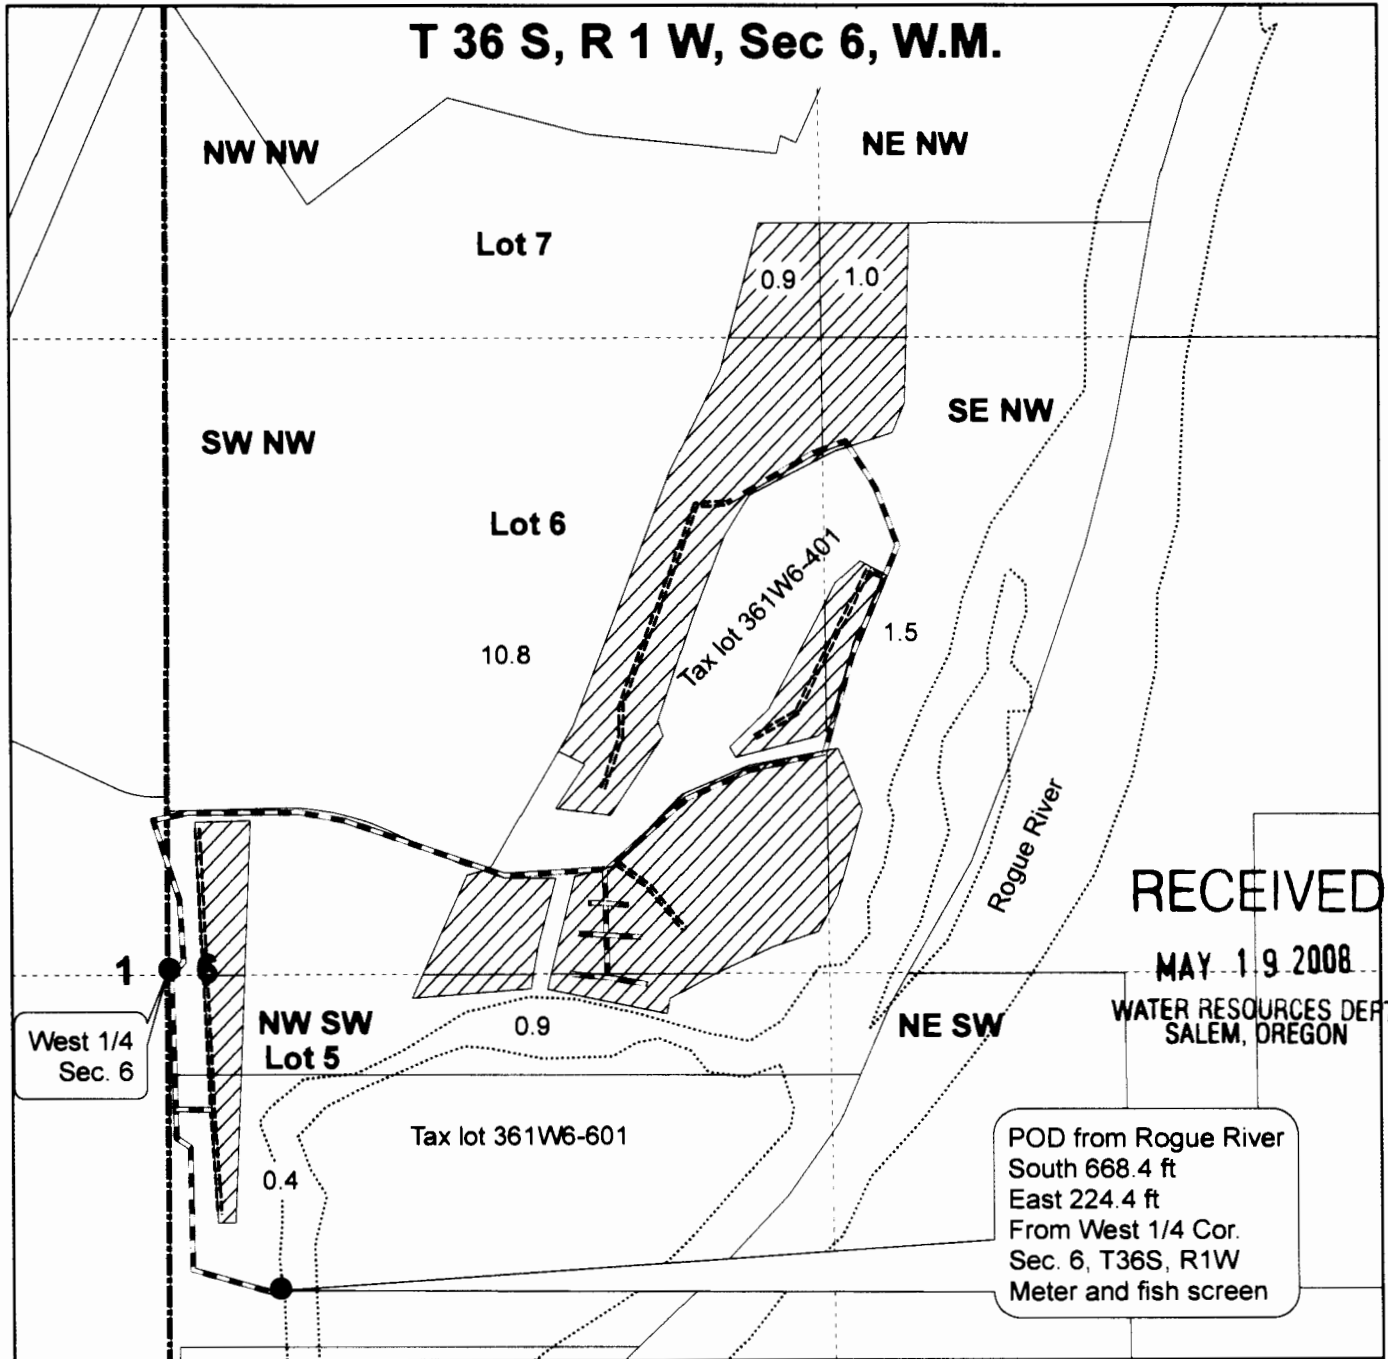


RRIP, Limited
 Application S-84709
 Permit S-53797



Source: Lost Creek Reservoir

T 36 S, R 1 W, Sec 6, W.M.

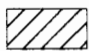

Legend

-  Area under irrigation
-  Pipeline, underground
-  Pipeline, surface

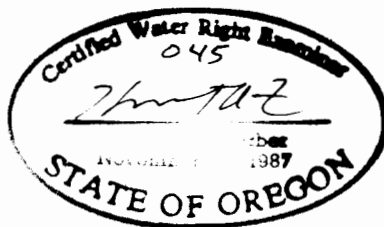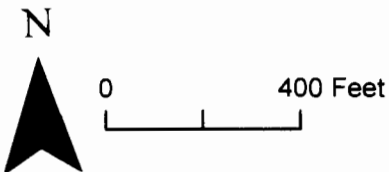

RENEWAL DATE 12-31-09

This map is not intended to provide legal dimensions or locations of property ownership lines.



PO Box 5286
 Central Point, Oregon 97502
 Phone 541-664-5599
 Fax 541-664-5603
 Email hfarber@charter.net

Farber & Sons, Inc.
 431 Oak Street
 Central Point, Oregon
 Tax ID: 93-1057173