


T. 9 S., R. 3 W., W.M.

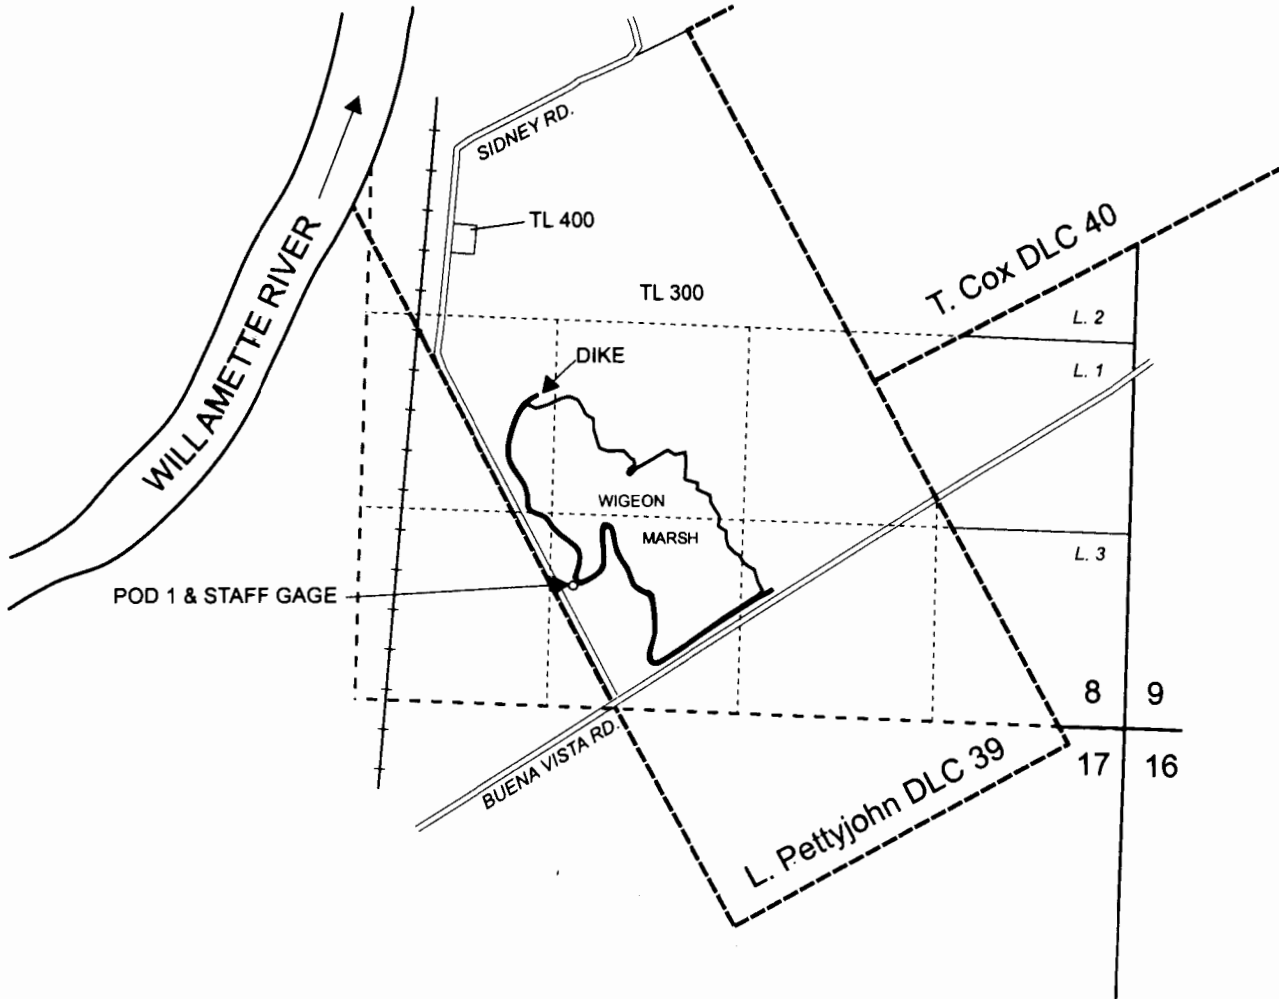

1 INCH = 1320 FEET

POD 1 IS LOCATED 3815 FT SOUTH AND 825 FT WEST FROM THE NW CORNER OF T. COX DLC 40.

RECEIVED

OCT 01 2009

WATER RESOURCES DEPT
SALEM, OREGON

FINAL PROOF SURVEY


UNDER

Application No. R-85235 Permit No. R-13461

IN THE NAME OF

U.S. FISH & WILDLIFE SERVICE

(WIGEON MARSH)

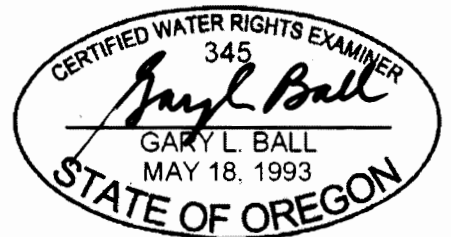

RENEWS: 12/31/2009

This map is not intended to provide legal dimensions or locations of property ownership lines.