


COBU MAP # 0444 / of 3

# CLAIM OF BENEFICIAL USE MAP

APPLICATION #R-86364, PERMIT # R-14242

LOCATED IN THE SW 1/4 SE 1/4 OF SECTION 22  
AND THE NE 1/4 NE 1/4 OF SECTION 27  
TOWNSHIP 12 SOUTH, RANGE 15 EAST,  
W.M., JEFFERSON COUNTY, OREGON

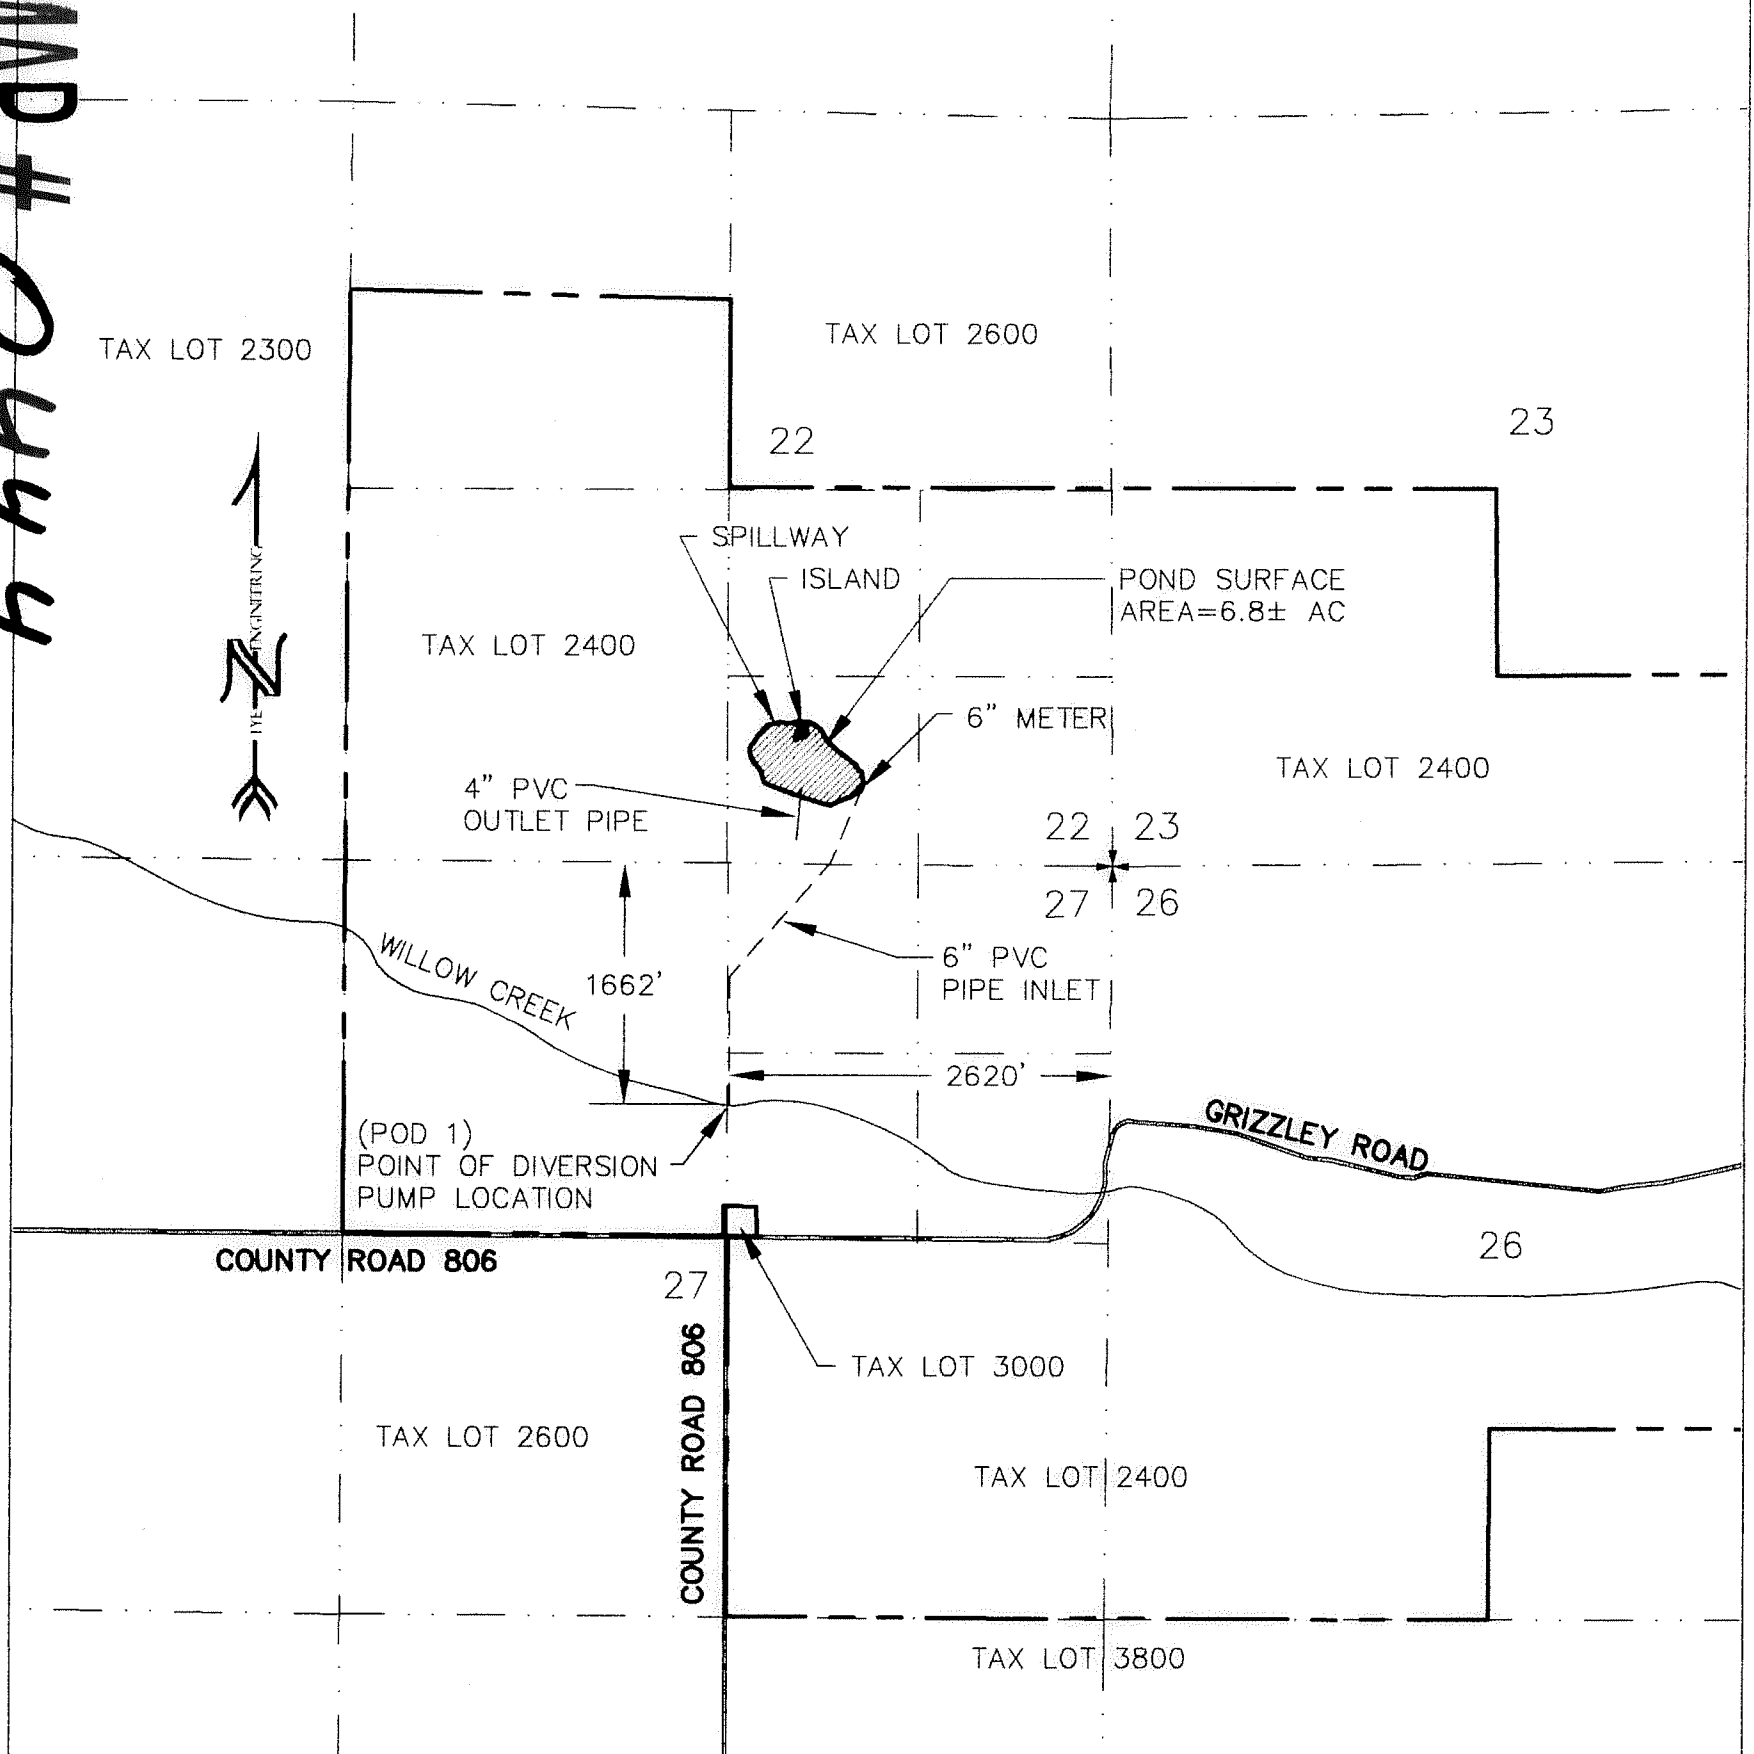


RECEIVED

AUG 06 2009

WATER RESOURCES DEPT  
SALEM, OREGON

I, WILLIAM R. TYE, CERTIFIED WATER RIGHT EXAMINER  
IN THE STATE OF OREGON, HEREBY CERTIFY THE  
CLAIM OF BENEFICIAL USE MAP WAS PREPARED  
UNDER MY DIRECT SUPERVISION.

THE PREPARATION OF THIS MAP IS FOR THE  
PURPOSE OF IDENTIFYING THE LOCATION OF THE  
WATER RIGHT ONLY AND HAS NO INTENT TO  
PROVIDE DIMENSIONS OR LOCATIONS OF PROPERTY  
OWNERSHIP LINES.

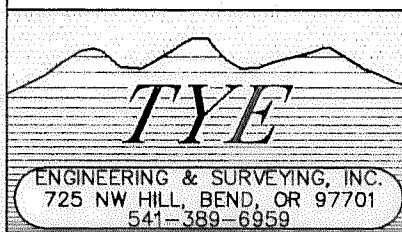

TITLE: FESSLER-CLAIM OF BENEFICIAL USE MAP - PERMIT NO. R-14242

JOB NO: 1712 - GLENN FESSLER

SCALE: 1"=1320'

FIELD BOOK NO:

DWG NAME: 1712-22

DRAWN BY: ATT

DATE: 7/24/09

SHEET: 1 OF 3

h h h O



# CLAIM OF BENEFICIAL USE MAP

APPLICATION #R-86364, PERMIT # R-14242

LOCATED IN THE SW 1/4 SE 1/4 OF SECTION 22  
AND THE NE 1/4 NE 1/4 OF SECTION 27  
TOWNSHIP 12 SOUTH, RANGE 15 EAST,  
W.M., JEFFERSON COUNTY, OREGON

CALCULATED SURFACE AREA=6.8 AC.  
CALCULATED CAPACITY @ HIGH WATER MARK=30.1 A.F.


COMPUTED VOLUME  
USING AUTODESK LAND DESKTOP  
VERSION 3, 2002

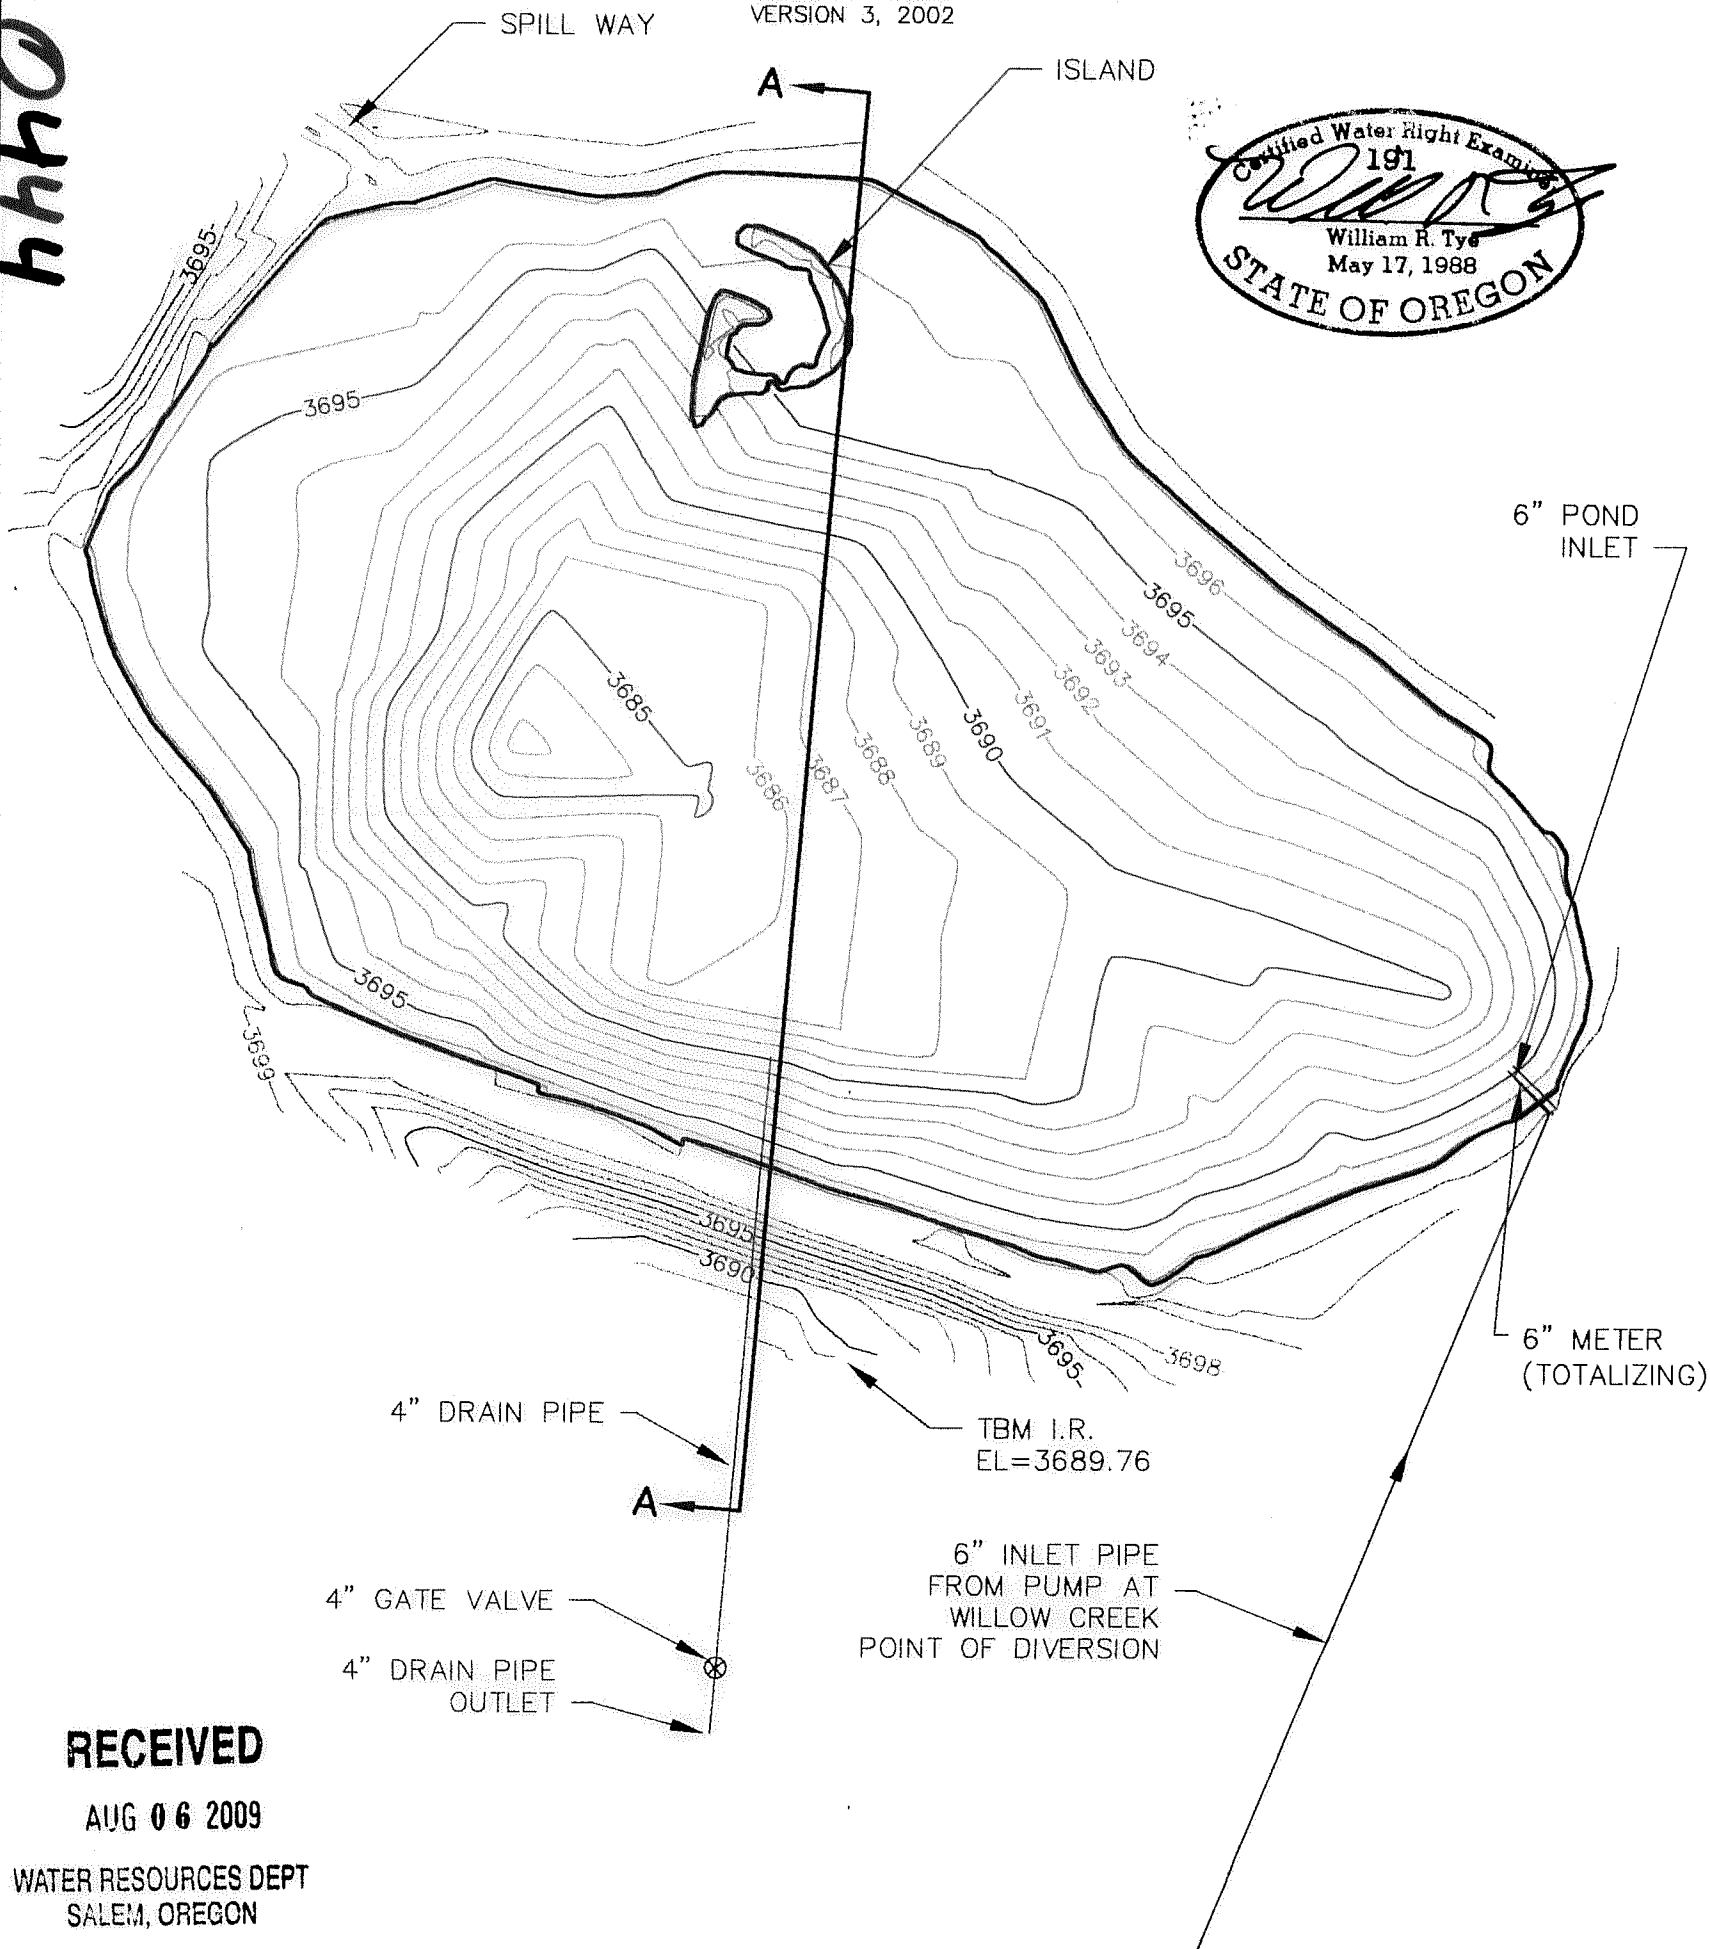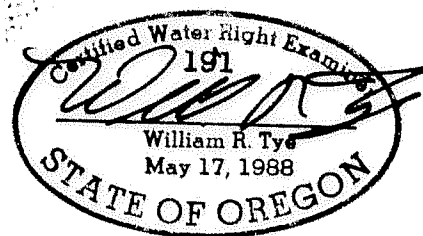

RECEIVED

AUG 06 2009

WATER RESOURCES DEPT  
SALEM, OREGON

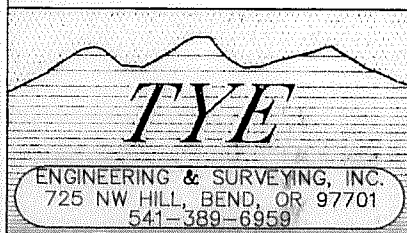

TITLE: FESSLER-CLAIM OF BENEFICIAL USE MAP - RES NO. 1 DETAIL

JOB NO: 1712 - GLENN FESSLER

SCALE: 1"=100'

DRAWN BY: ATT

FIELD BOOK NO:

DATE: 7/24/09

DWG NAME: 1712-22

SHEET: 2 OF 3


hhho

COBU MAP # 0444  
2 of 3

# CLAIM OF BENEFICIAL USE MAP

APPLICATION #R-86364, PERMIT # R-14242


LOCATED IN THE SW 1/4 SE 1/4 OF SECTION 22  
AND THE NE 1/4 NE 1/4 OF SECTION 27  
TOWNSHIP 12 SOUTH, RANGE 15 EAST,  
W.M., JEFFERSON COUNTY, OREGON

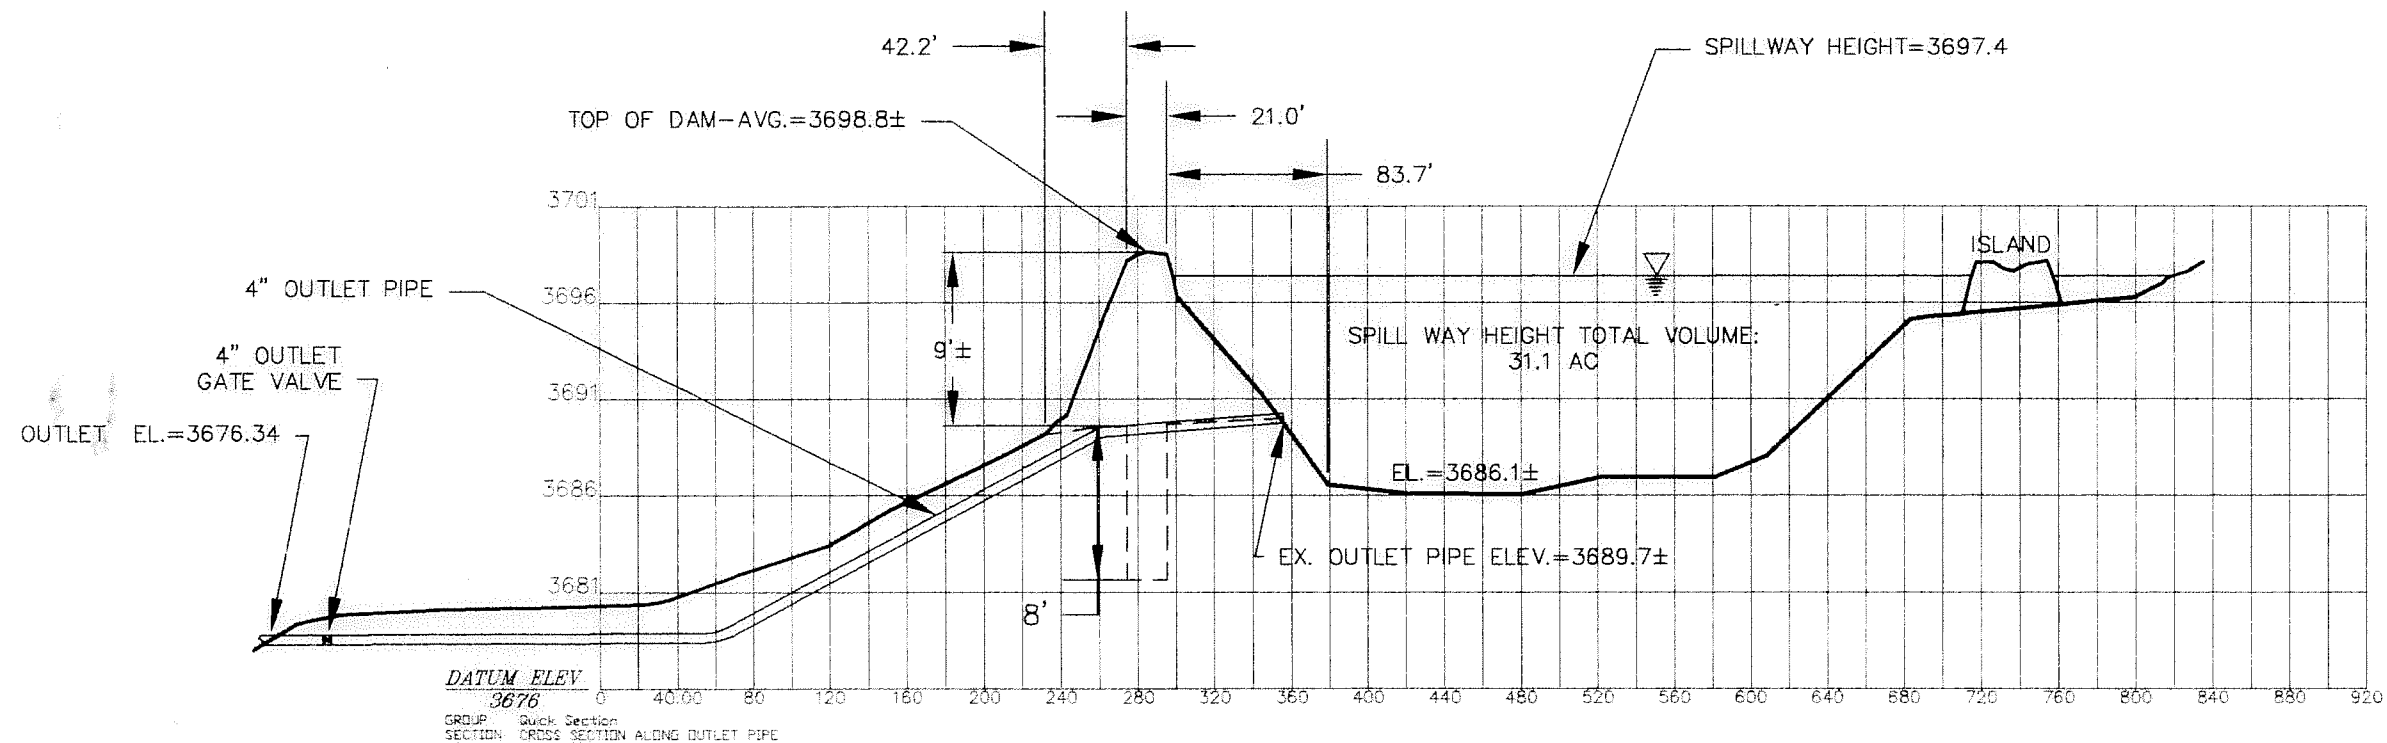

## CROSS SECTION A-A


SCALE: HOR.: 1"=100'; VERT.: 1"=10'

COBU MAP # 0444 3 of 3

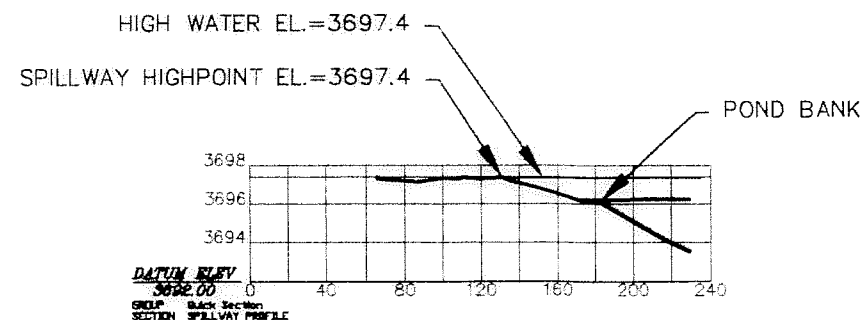


## SPILLWAY PROFILE

SCALE: HOR.: 1"=100'; VERT.: 1"=10'

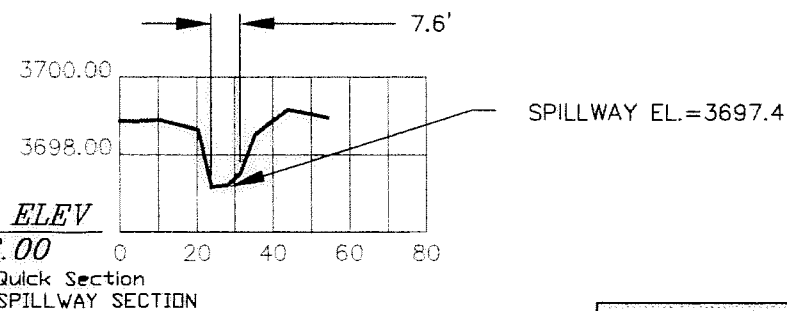

## SPILLWAY SECTION


SCALE: HOR.: 1"=50'; VERT.: 1"=5'

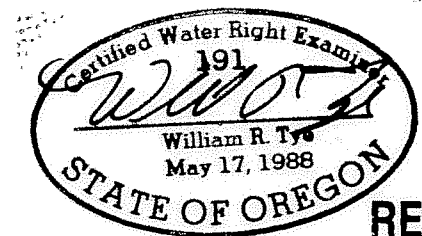

RECEIVED

AUG 06 2009

WATER RESOURCES DEPT  
SALEM, OREGON

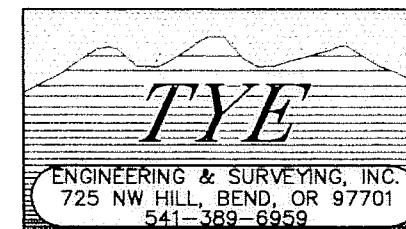

|                                    |               |
|------------------------------------|---------------|
| TITLE: CLAIM OF BENEFICIAL USE MAP |               |
| JOB NO: 1712 - GLENN FESSLER       |               |
| SCALE: 1"=100'                     | DRAWN BY: ATT |
| FIELD BOOK NO:                     | DATE: 7/24/09 |
| DWG NAME: 1712-22                  | SHEET: 3 OF 3 |