

Lands with primary rights from Wells 1, 2 and 3.

Existing buried mainline

Well number 1 is 44' North and 2589' West of the West quarter corner of Section 29.

Well number 2 is 110' North and 100 East of the West quarter corner of Section 29.

Well number 3 is 100 North and 2748' East of the West quarter corner of Section 29.

SCALE: 1"=1320'

JUNE 17, 2008


**FINAL PROOF MAP OF
WATER RIGHTS FROM
WELLS #1, #2 AND #3**

FOR

BRETT RUDD, PAUL & JANET RUDD

BY

**BAGETT - GRIFFITH & BLACKMAN
2006 ADAMS AVENUE
LAGRANDE, OREGON 97850**

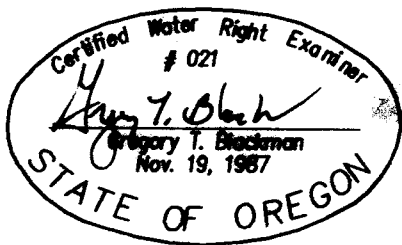

NOTE: The preparation of this map was for the purpose of identifying the location of the proposed water right and has no intent to provide dimensions or location of property ownership lines. Location information shown hereon was furnished by the applicant.

RECEIVED

SEP 18 2008
WATER RESOURCES DEPT
SALEM, OREGON

APPLICATION NO. G- 16028

PERMIT NUMBER G- 16028