


SECTION 16, TWP.3 S. RANGE 16 E. W.M.
SHERMAN COUNTY, OREGON

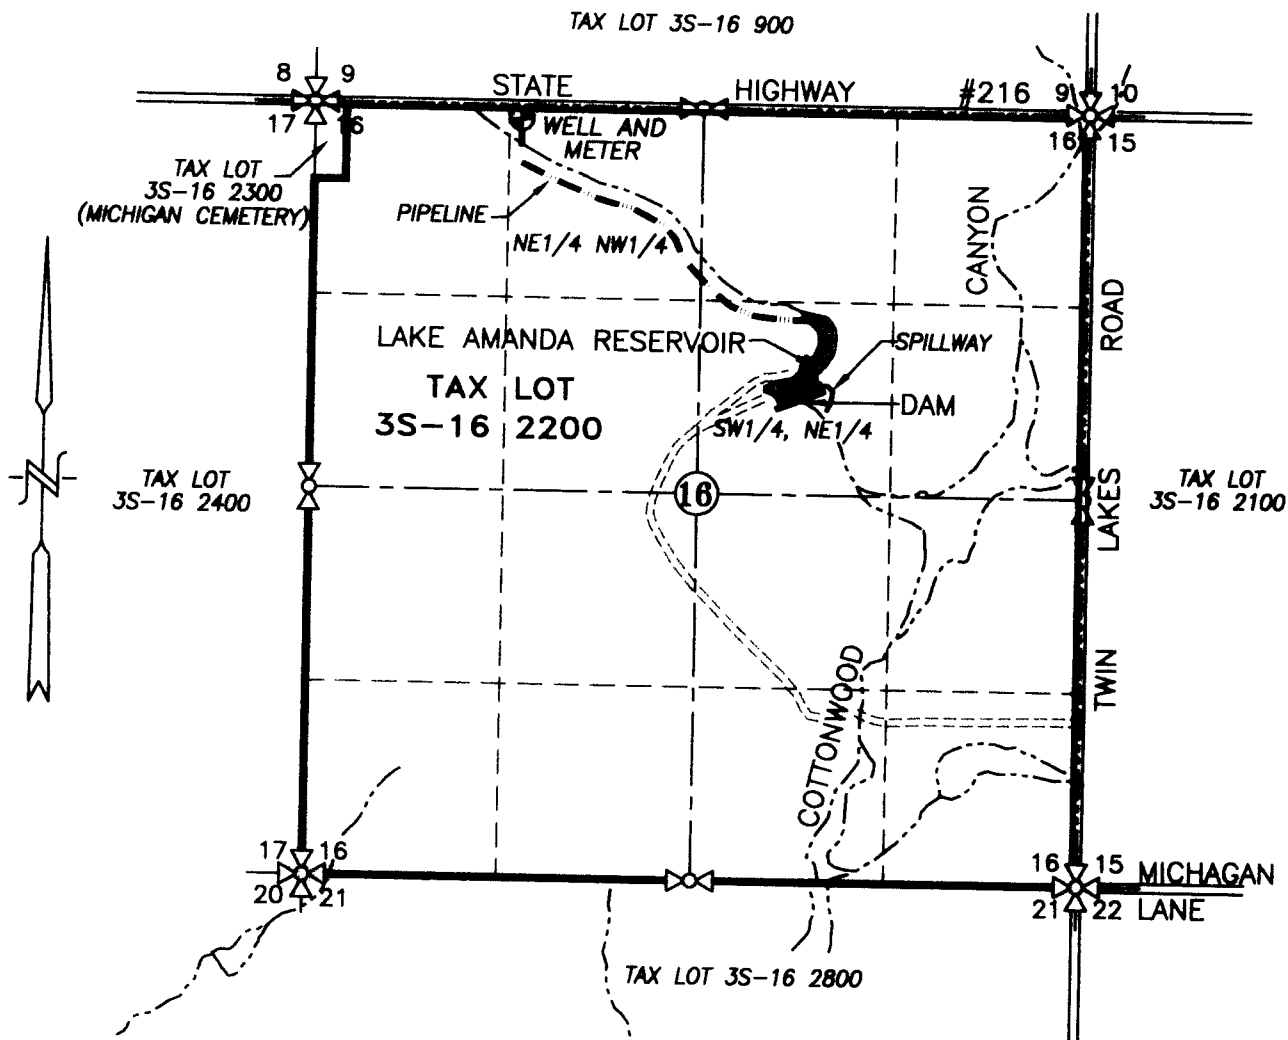

LEGEND:

- ⊕ EXISTING WELL, 95' S. & 405' E. OF NW CORNER SECTION 16
- AMANDA DAM, 1970' S. & 3340' E. OF NW COR. SEC. 16

■ LAKE AMANDA RESERVOIR AREA = 2.4 ACRES

--- EXISTING PIPELINE

RECEIVED

APR 09 2009

WATER RESOURCES DEPT
SALEM, OREGON

WATER RIGHT

CLAIM OF BENEFICIAL USE MAP

SCALE: 1" = 1320'


APPLICATION No. G 15497

PERMIT No. G 15143

IN THE NAME OF:

FRED JUSTESEN

DATE: FEBRUARY 25, 2009

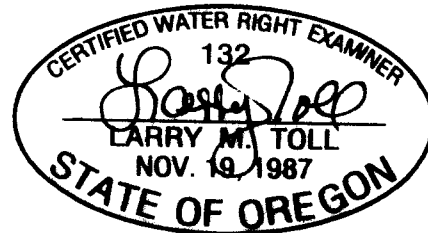

EXPIRES: 06/30/2010

BY: **TENNESON ENGINEERING Corp.**
3313 W. 2ND. STREET, SUITE 100
THE DALLES, OREGON. 97058
PH. (541) 296-9177
FAX (541) 296-6657



NOTE:

"THIS MAP IS NOT INTENDED TO
PROVIDE DIMENSIONS OR LOCATIONS
OF PROPERTY OWNERSHIP LINES."

W.O. #12583wr

COBUC MAP #0423