


421

SECTIONS 10 TWP. 3 S. RANGE 16 E. W.M. SHERMAN COUNTY, OREGON

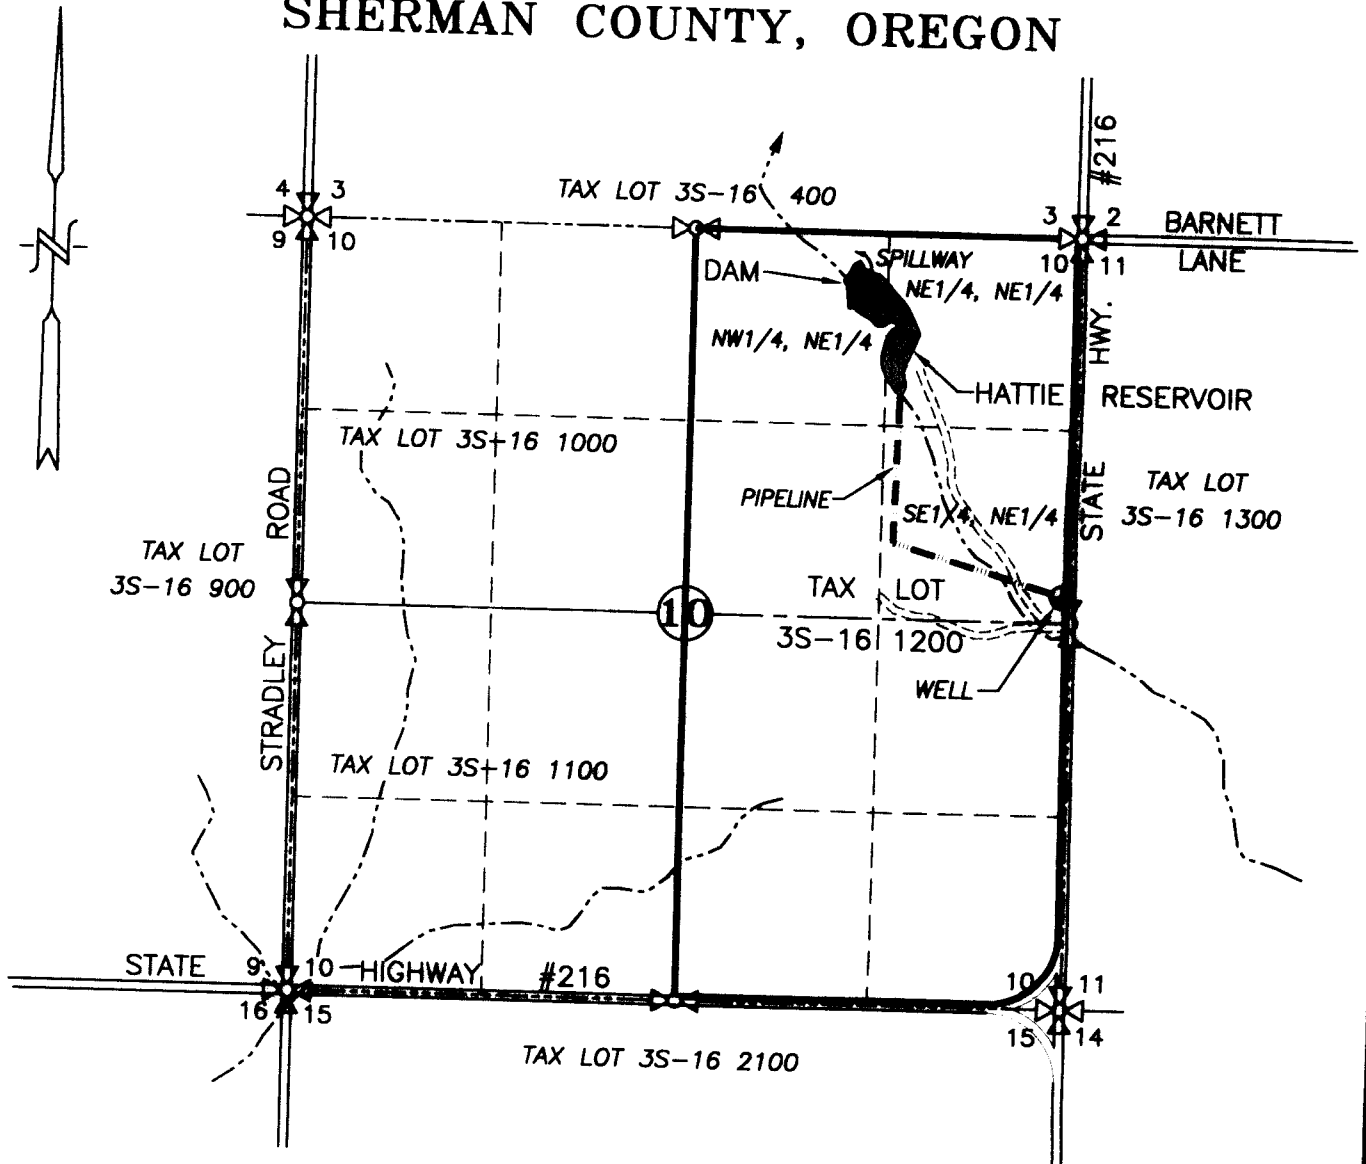

LEGEND:

- ⊕ WELL: 2465' S. & 55' W. OF NE CORNER SECTION 10
- CENTER OF DAM: 330' S. & 1580' W. OF NE COR. SECTION 10
- EXISTING HATTIE RESERVOIR AND DAM
- PIPELINE

RECEIVED

APR 09 2009

WATER RESOURCES DEPT
SALEM, OREGON

WATER RIGHT

CLAIM OF BENEFICIAL USE MAP

SCALE: 1" = 1320'


APPLICATION No. G-15797

PERMIT No. G-15345

IN THE NAME OF:

FRED JUSTESEN

DATE: FEBRUARY 25, 2009

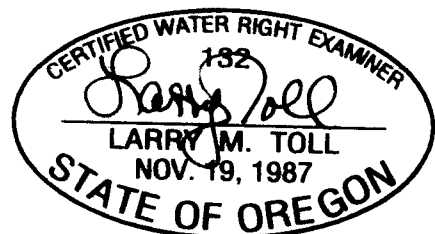

EXPIRES: 06/30/2010

BY: **TENNESON ENGINEERING CORP.**

3313 W. 2ND. STREET, SUITE 100
THE DALLES, OREGON. 97058
PH. (541) 296-9177
FAX (541) 296-6657



NOTE:

"THIS MAP IS NOT INTENDED TO
PROVIDE DIMENSIONS OR LOCATIONS
OF PROPERTY OWNERSHIP LINES."

W.O. #13067wr

COBU MAP #0421