

SECTIONS 1, 2, 11 AND 12, TOWNSHIP 5 S. RANGE 15 E. W.M.
 WASCO COUNTY, OREGON

TAX LOT 100, MAP 5S-15

**RESERVOIR CLAIM OF
 BENEFICIAL USE MAP**

SCALE: 1" = 1320'

- ▶ RESERVOIR #1 (2260' SOUTH AND 4885' WEST)
- ▶ RESERVOIR #2 (1515' SOUTH AND 2620' WEST)
- ▶ RESERVOIR #3 (780' SOUTH AND 665' WEST)
- ▶ RESERVOIR #4 (145' SOUTH AND 67' WEST)
- ▶ RESERVOIR #5 (405' NORTH AND 1105' EAST)
- ▶ RESERVOIR #6 (210' SOUTH AND 1310' EAST)

ALL FROM THE NE CORNER SECTION 11

APPLICATION No. R-86358, R-86359, R-86360
 R-86361, R-86362, R-86363

PERMIT No. R-14228, R-14229, R-14230
 R-14231, R-14232, R-14233

IN THE NAME OF:
 A & K RANCHES

RECEIVED


DATE: APRIL 22, 2009

MAY 11 2009

WATER RESOURCES DEPT
 SALEM, OREGON

BY: **TENNESON ENGINEERING CORP.**

3313 W. 2nd. STREET, SUITE 100
 THE DALLES, OREGON. 97058
 PH. (541) 296-9177
 FAX (541) 296-6657

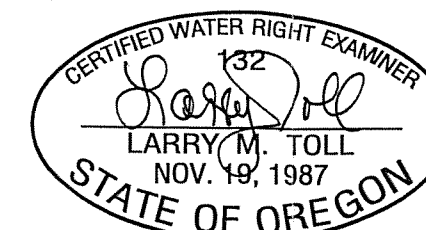

NOTE:

"THIS MAP IS NOT INTENDED TO
 PROVIDE DIMENSIONS OR LOCATIONS
 OF PROPERTY OWNERSHIP LINES."

EXPIRES: 06/30/2010

W.O. #10695wr2(RES)

