


T.6 S., R.1W., Section 35, W.M.

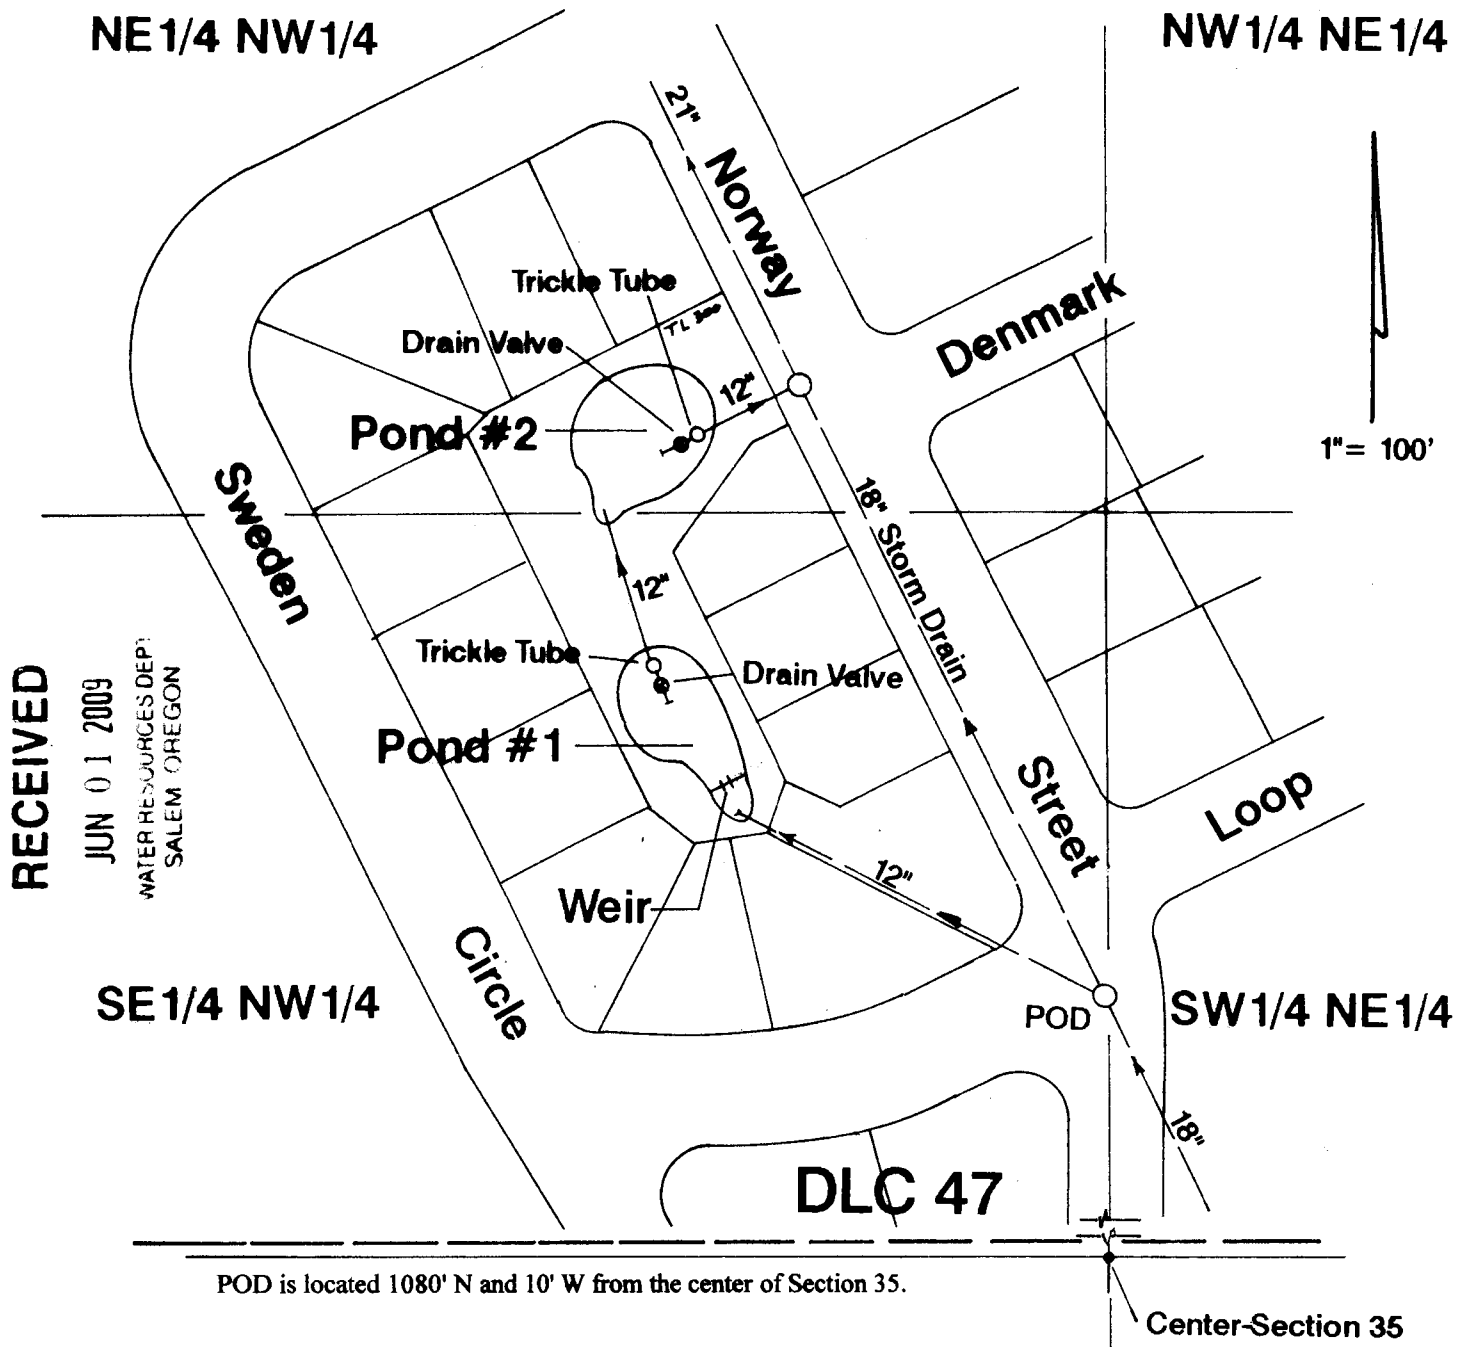

Claim of Beneficial Use Map

Oak Knoll Estates Homeowners Association

Application #: R-73087
S-73088

Permit #: R-11814
51978

This Map was Prepared for the Purpose of Identifying the Location of a Water Right Only and is Not Intended to Provide Legal Dimensions or Location of Property Ownership Lines.

