

T. 23 S., R. 8 W., W.M.

SCALE: 1" = 400'

SECTION CORNER
SECTION 1, 2, 11, & 12,
TOWNSHIP 23 SOUTH, RANGE 8 WEST
WILLAMETTE MERIDIAN,
DOUGLAS COUNTY, OREGON
FD. BRASS CAP

COUNTY ROAD NO. 11

UMPQUA RIVER

N.E. of the N.E.
SECTION 11
4.58 ACRE-FEET STORED

FLOW METER LOCATION

N.W. of the N.W.
SECTION 12
0.09 ACRE-FEET STORED

DAM

PAT'S POND
OUTLET WORKS

S.E. of the N.E.
SECTION 11
8.98 ACRE-FEET STORED

S.W. of the N.W.
SECTION 12
4.67 ACRE-FEET STORED

POINT OF DIVERSION IS 1015 FEET SOUTH
AND 91 FEET EAST OF THE NORTHEAST
CORNER OF SECTION 11, TOWNSHIP 23
SOUTH, RANGE 8 WEST, WILLAMETTE
MERIDIAN, DOUGLAS COUNTY, OREGON.

FLOW METER LOCATION IS 1111 FEET SOUTH
AND 9 FEET WEST OF THE NORTHEAST
CORNER OF SECTION 11, TOWNSHIP 23
SOUTH, RANGE 8 WEST, WILLAMETTE
MERIDIAN, DOUGLAS COUNTY, OREGON.

THE PURPOSE OF THIS MAP IS TO IDENTIFY
THE LOCATION OF THE WATER RIGHT. IT IS
NOT INTENDED TO PROVIDE INFORMATION
RELATIVE TO THE LOCATION OF PROPERTY
OWNERSHIP BOUNDARY LINES.

1/4 SECTION CORNER
SECTION 11, & 12,
TOWNSHIP 23 SOUTH, RANGE 8 WEST,
WILLAMETTE MERIDIAN,
DOUGLAS COUNTY, OREGON
FD. BRASS CAP

PAT'S POND

N.E. of the N.E.	4.58
S.E. of the N.E.	8.98
S.W. of the N.W.	4.67
N.W. of the N.W.	0.09

18.32 AC. FT. TOTAL

FINAL PROOF SURVEY


UNDER

Application No. R-86118 Permit No. R-14130

IN NAME OF

THOMAS HANSCH

Surveyed: APRIL 6, 2009 by R.F.BROWN

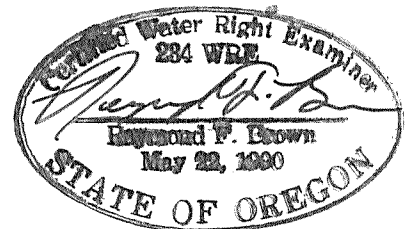

EXP. 12/31/09

COBU MAP # 0471

