


CLAIM OF BENEFICIAL USE MAP FOR PERMIT R-14244

T. 35 S., R. 6 W., W. M., JOSEPHINE COUNTY

Section 2 SE1/4 SE1/4

August 15, 2009

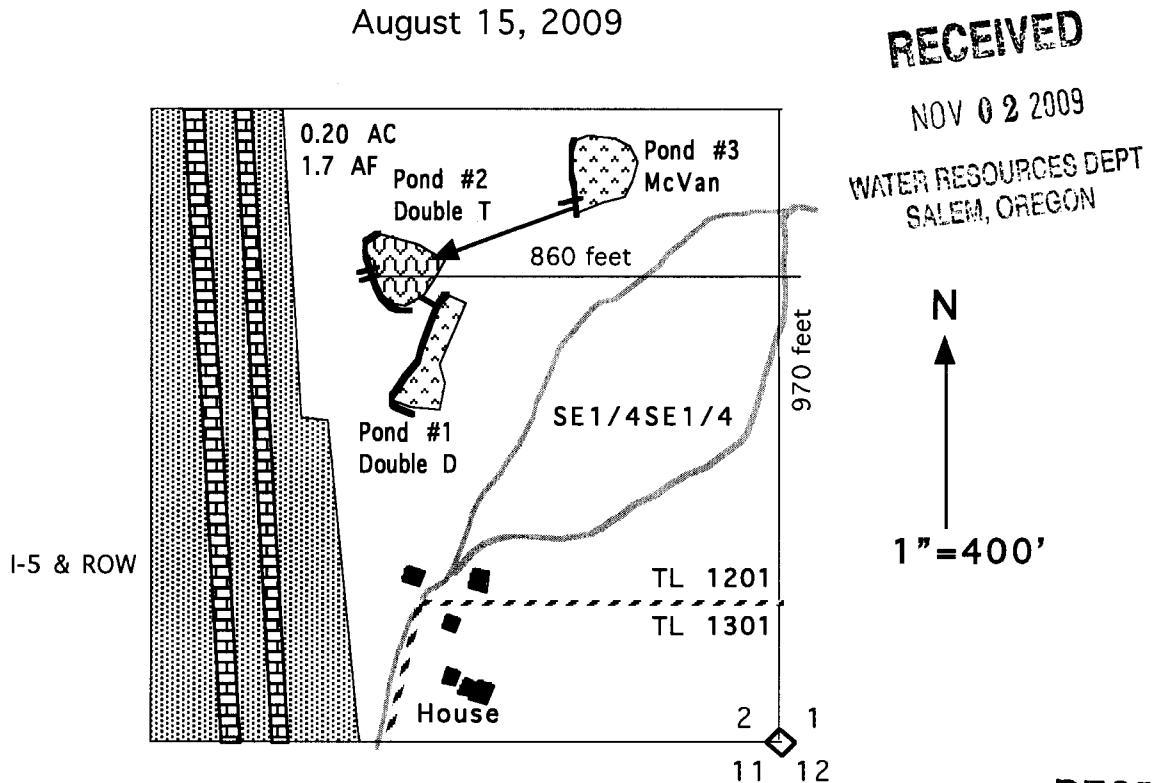

 Pond #2 (Double T) storing 1.7 acre-feet of water for multiple purpose uses in a reservoir constructed under Application R-86288 and Permit R-14244 with a priority of May 2, 2005.

 Dams


 15 inch diameter spillway culverts.

 Pond #1 and Pond #3.

 Gravel roads

 Buildings

 Buried 3 inch diameter PVC pipe.

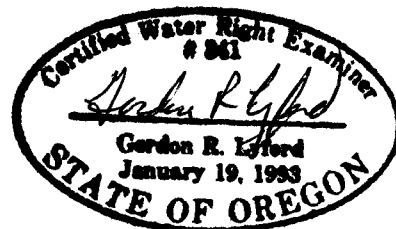

8-16-2009
exp 12-31-2010

This map was drawn by Gordon R. Lyford for Brad Vandehey to support his Claim of Beneficial Use to store water for multiple purpose uses. Brad Vandehey owns tax lots 1201 and 1301.

This map was prepared for the purposes of identifying the location of water rights only and is not intended to provide legal dimensions or the location of property ownership lines.