




T.12S., R.6W., WM. 1 6 T.12S., R.5W., WM

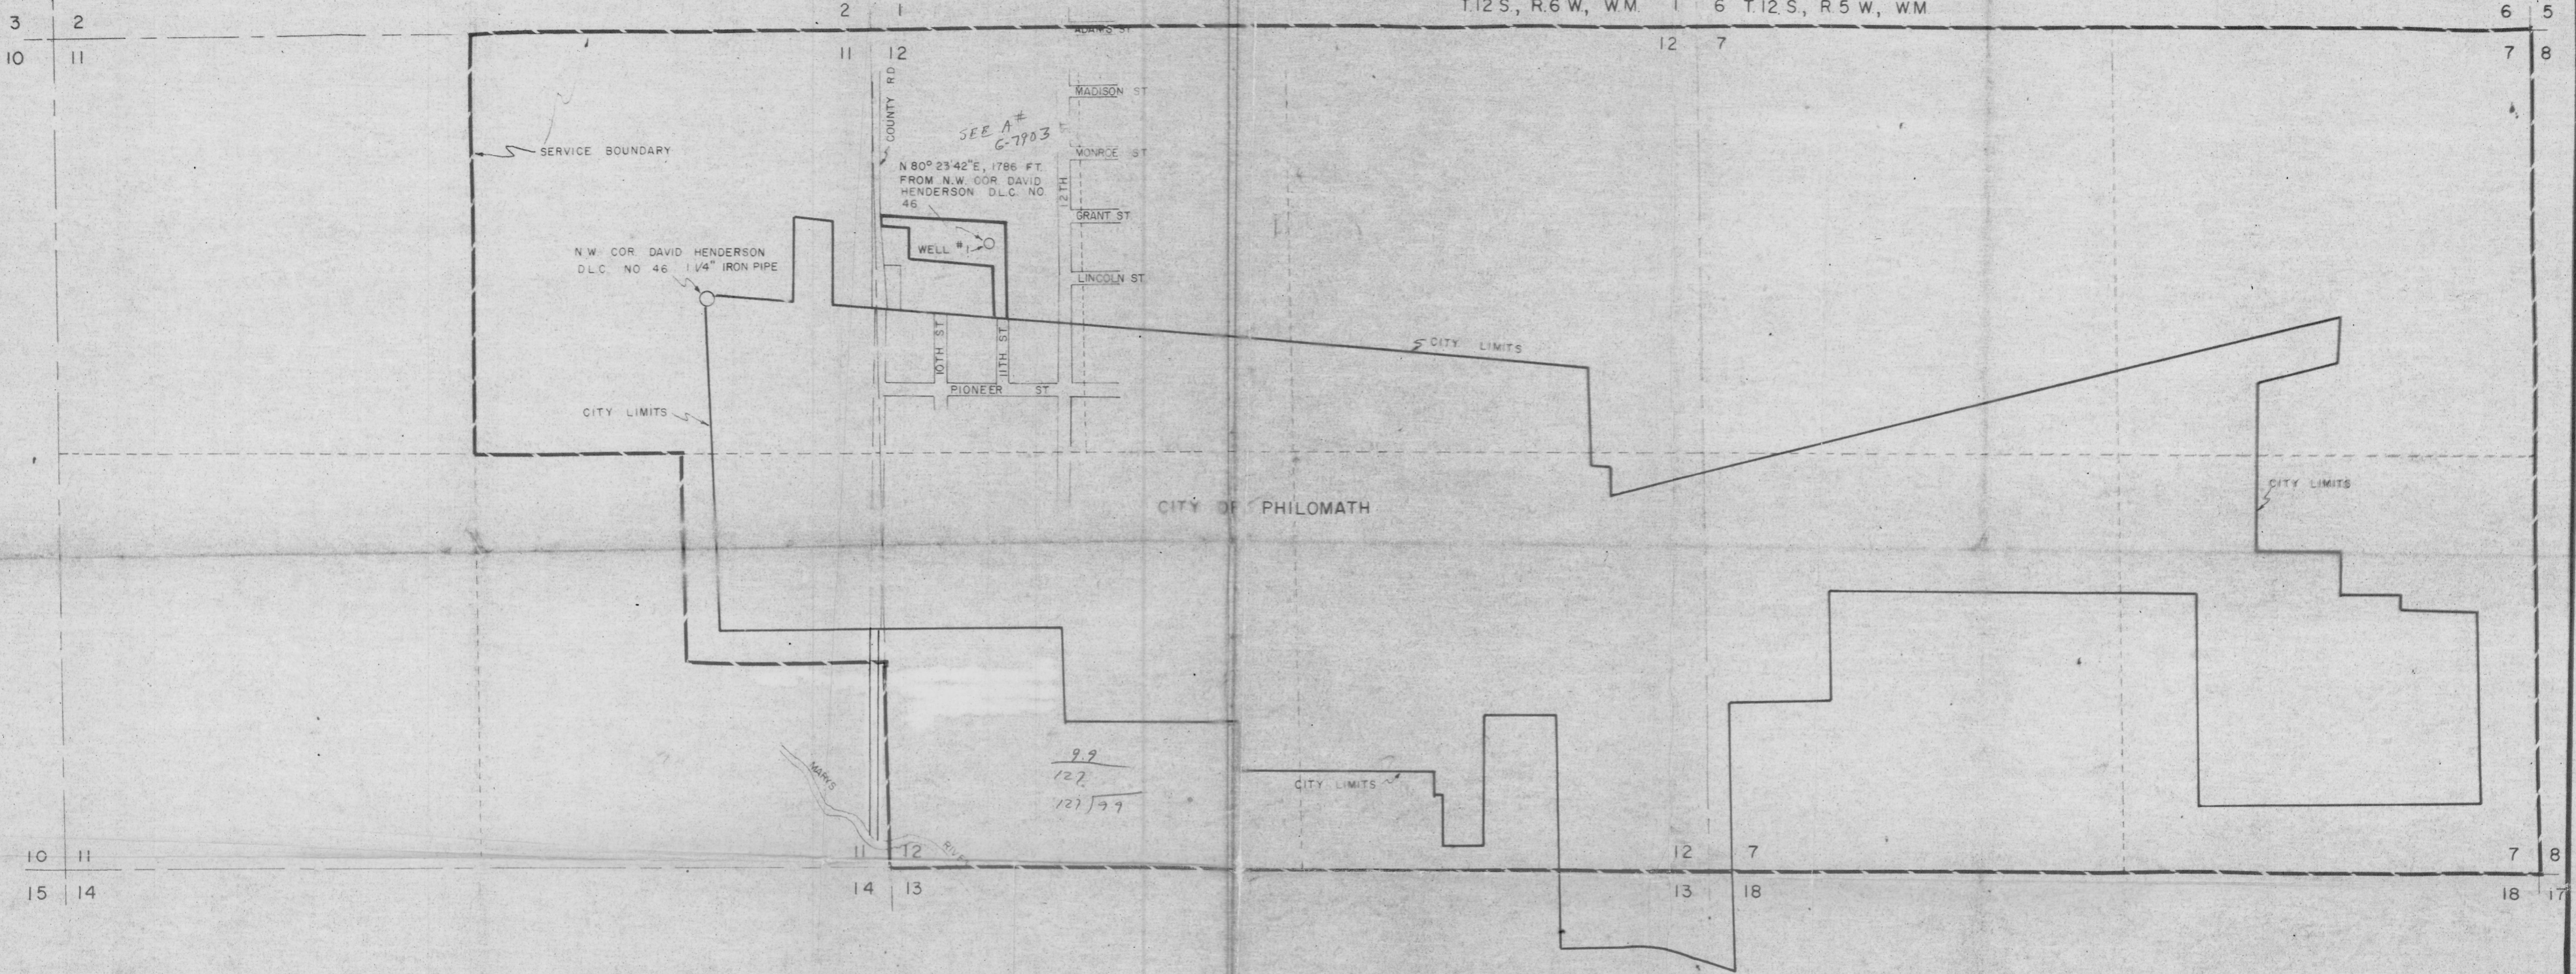

CITY OF PHILOMATH

SCALE 1" = 800'

Application No. G-10613  
Permit No. G 9728

CITY OF PHILOMATH PHILOMATH, OREGON  WATER TREATMENT FACILITY  NORTH 11th. STREET	DRAWN BY <u>D. BRINTON</u>
	CHECKED BY <u>N.L.P.</u>
	DRAWING NO. _____
	PROJECT NO. _____