

COBU MAP # 0258

Proof Survey Map

Application S-84608, Permit 53805

T36S, R2W, Sec. 12 & 13, W.M.

Table Rock Canal POD
333 feet south
1987 feet east
From NW Cor Sec 6
In Lot 7, Sec 6, T36S, R1W

RECEIVED
OCT 13 2006
WATER RESOURCES DEPT
SALEM, OREGON


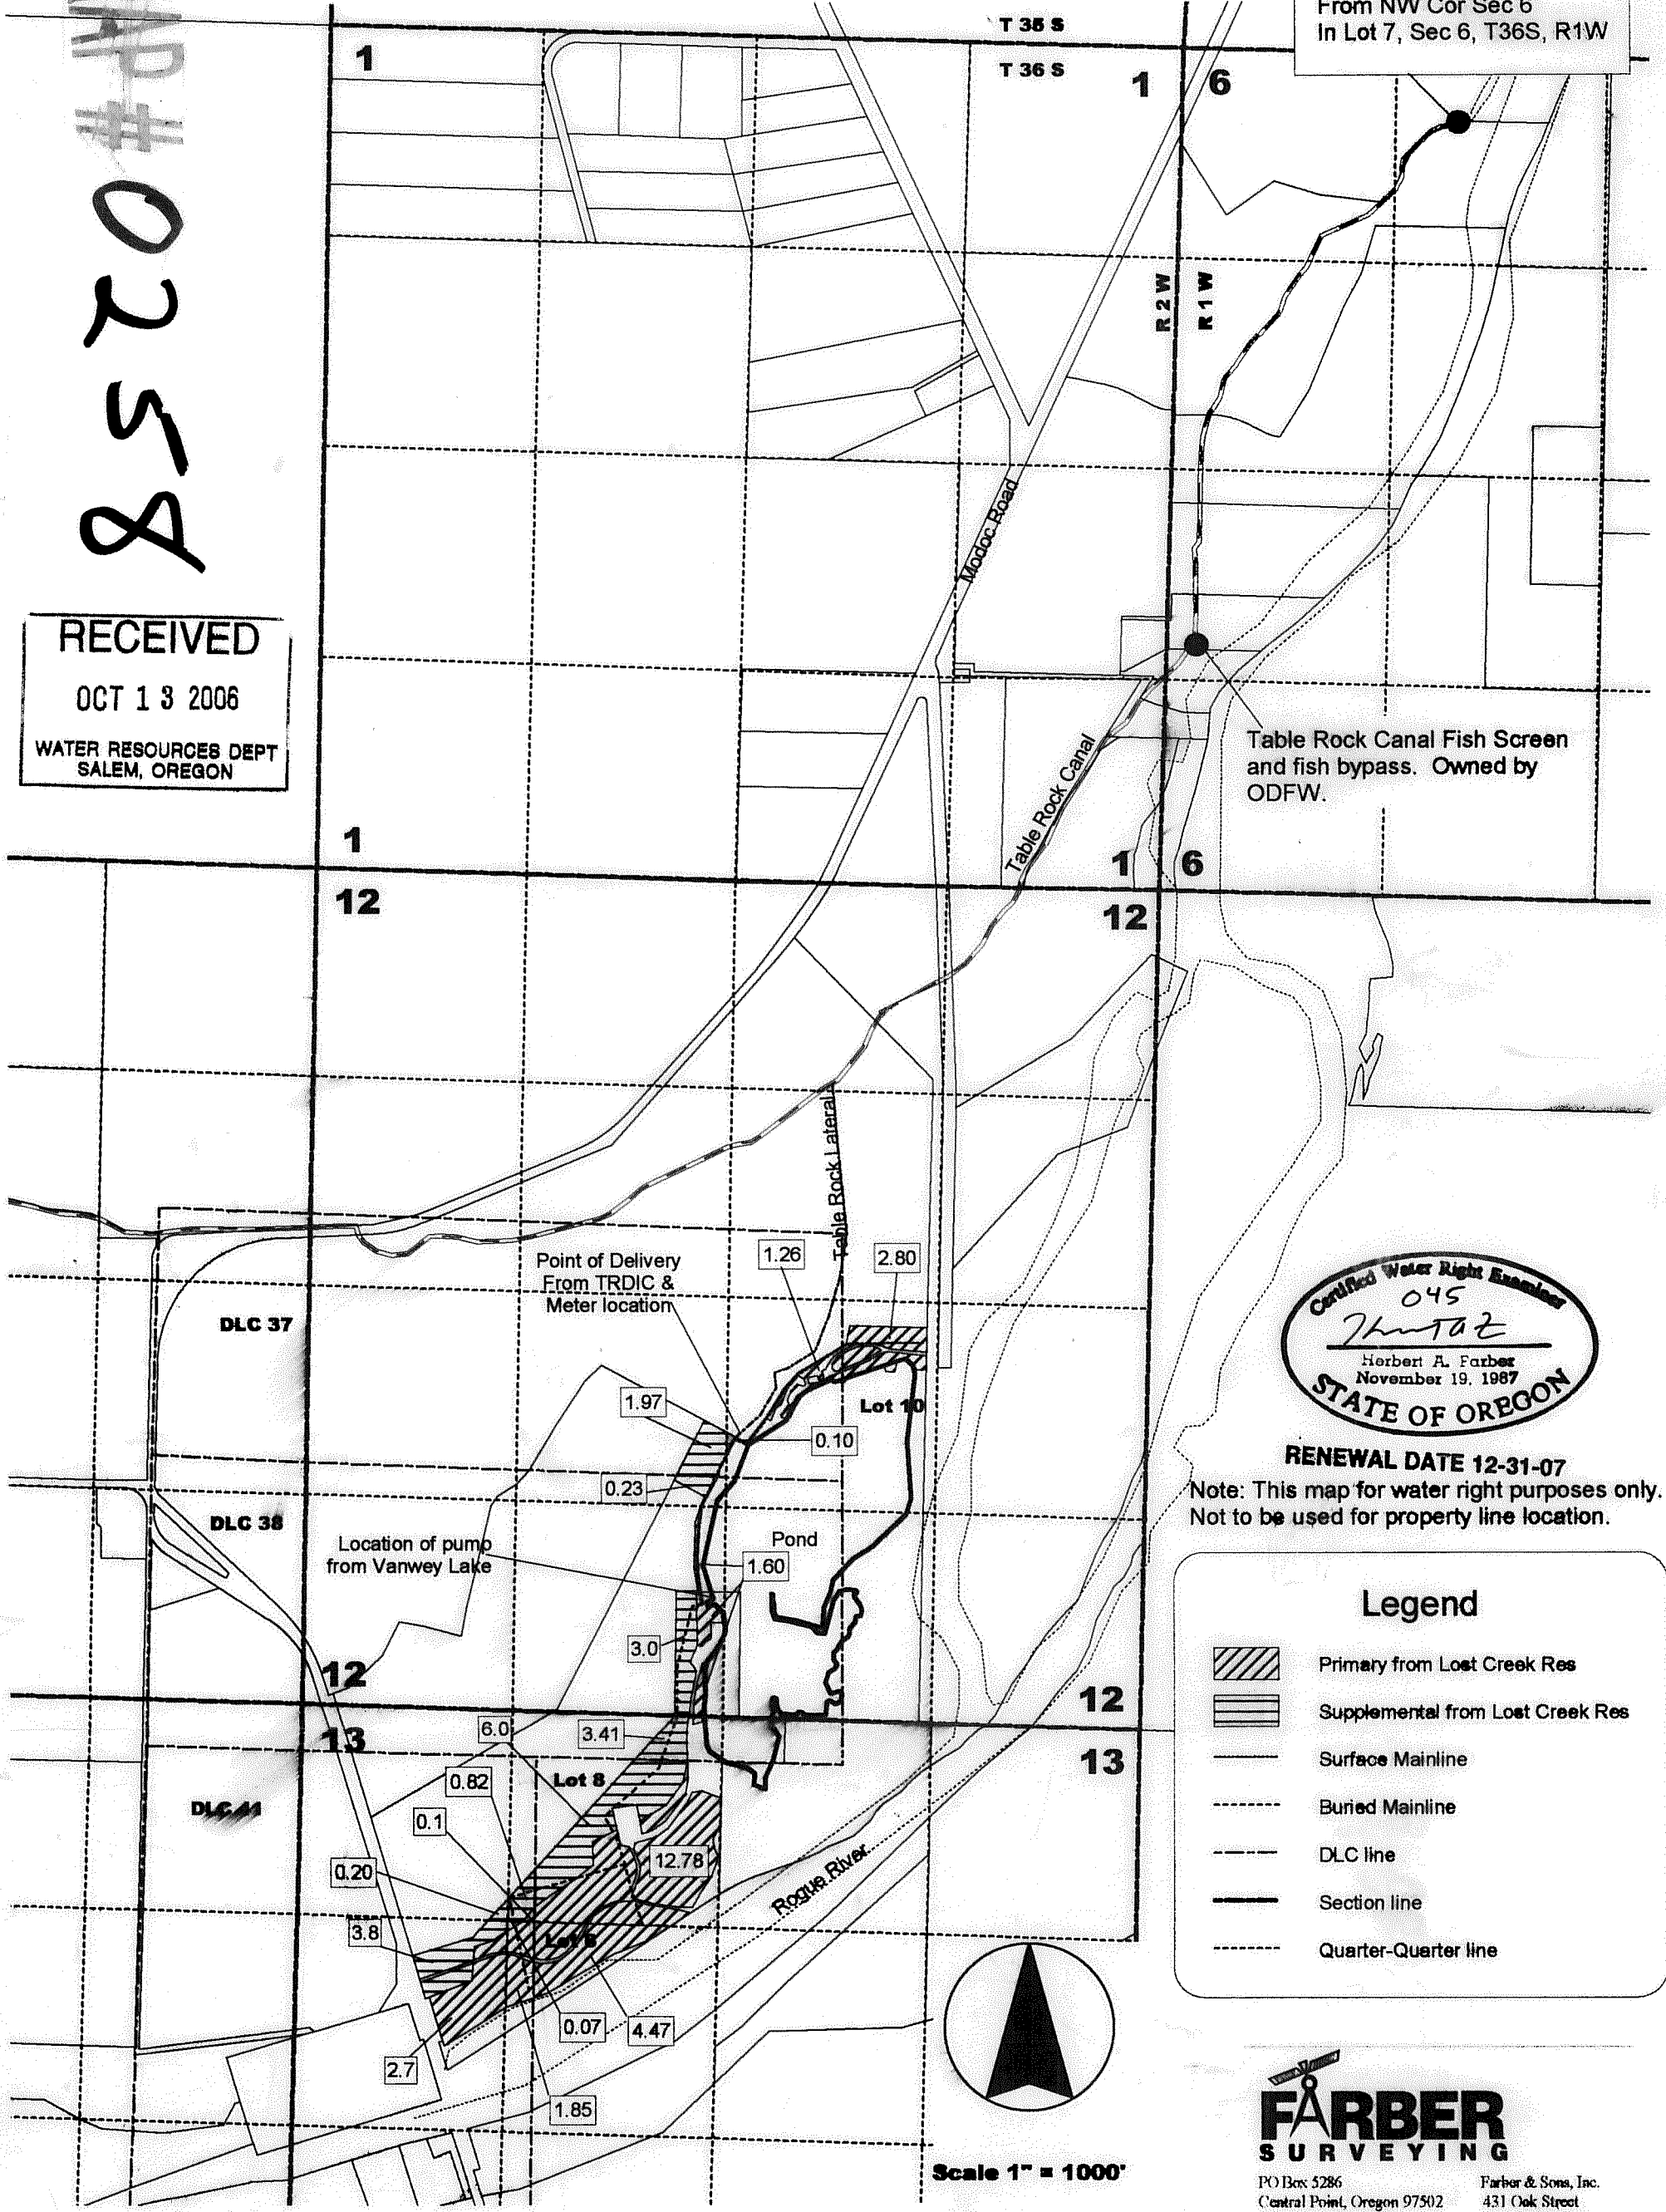


Table Rock Canal Fish Screen and fish bypass. Owned by ODFW.

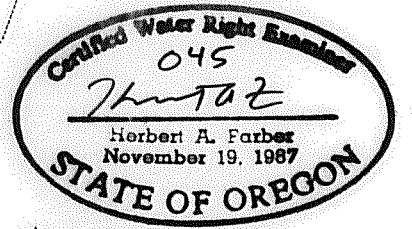


RENEWAL DATE 12-31-07

Note: This map for water right purposes only. Not to be used for property line location.

Legend

- Primary from Lost Creek Res
- Supplemental from Lost Creek Res
- Surface Mainline
- Buried Mainline
- DLC line
- Section line
- Quarter-Quarter line

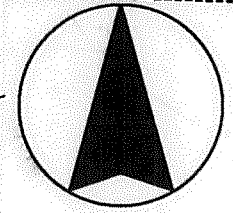

Scale 1" = 1000'

FARBER SURVEYING
PO Box 5286
Central Point, Oregon 97502
Phone 541-664-5599
Fax 541-664-5603
Email farber@farbersurveying.com
Farber & Sons, Inc.
431 Oak Street
Central Point, Oregon
Tax ID: 93-1057173

8500