



T27S R22E
T27S R23E

**T27S, R23E
SECTION 19, WM**

LAKE COUNTY, OREGON

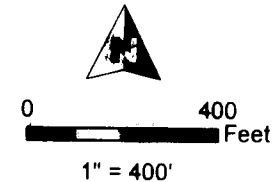

-  Township
-  Section
-  Quarter Quarter
-  Taxlot
-  Well
-  POU Irrigation

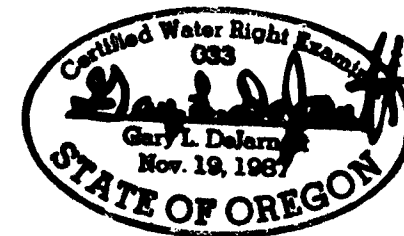

RENEWAL DATE 12/31/2015

19

WELL:
780' N, 10' E OF
W 1/4 COR SEC 19

CLAIM OF BENEFICIAL USE MAP
Matt King

AP G-16777

PERMIT G-16256

NOTE: THIS MAP IS NOT INTENDED TO
PROVIDE LEGAL DIMENSIONS OR LOCATIONS
OF PROPERTY OWNERSHIP LINES.

PROJECT #15037

JUNE 10, 2015

WATER RIGHT SERVICES, LLC
PO BOX 1830, BEND, OR 97709
CCB# 197121 www.oregonwater.us
541-389-2837 JOHNSHORT@USA.COM