


CLAIM OF BENEFICIAL USE
FOR: GARY D. BROWN
P.O.BOX 1405, MYRTLE CREEK OR.
BY: DUANE W. KIRBY
8087 LOOKINGGLASS RD
ROSEBURG, OR
APPLICATION NO. 83479
PERMIT NO. 53485
DATE: 2-6-07

Location: Sec. 36, T29S, R6W, WM


Scale: 1" = 400'

RECEIVED

SEP 27 2007

WATER RESOURCES DEPT
SALEM, OREGON

IRRIGATION	
SW NE	0.25 AC
SE NE	14.80 AC
NW SE	0.55 AC
NE SE	3.10 AC
TOTAL	18.7 AC

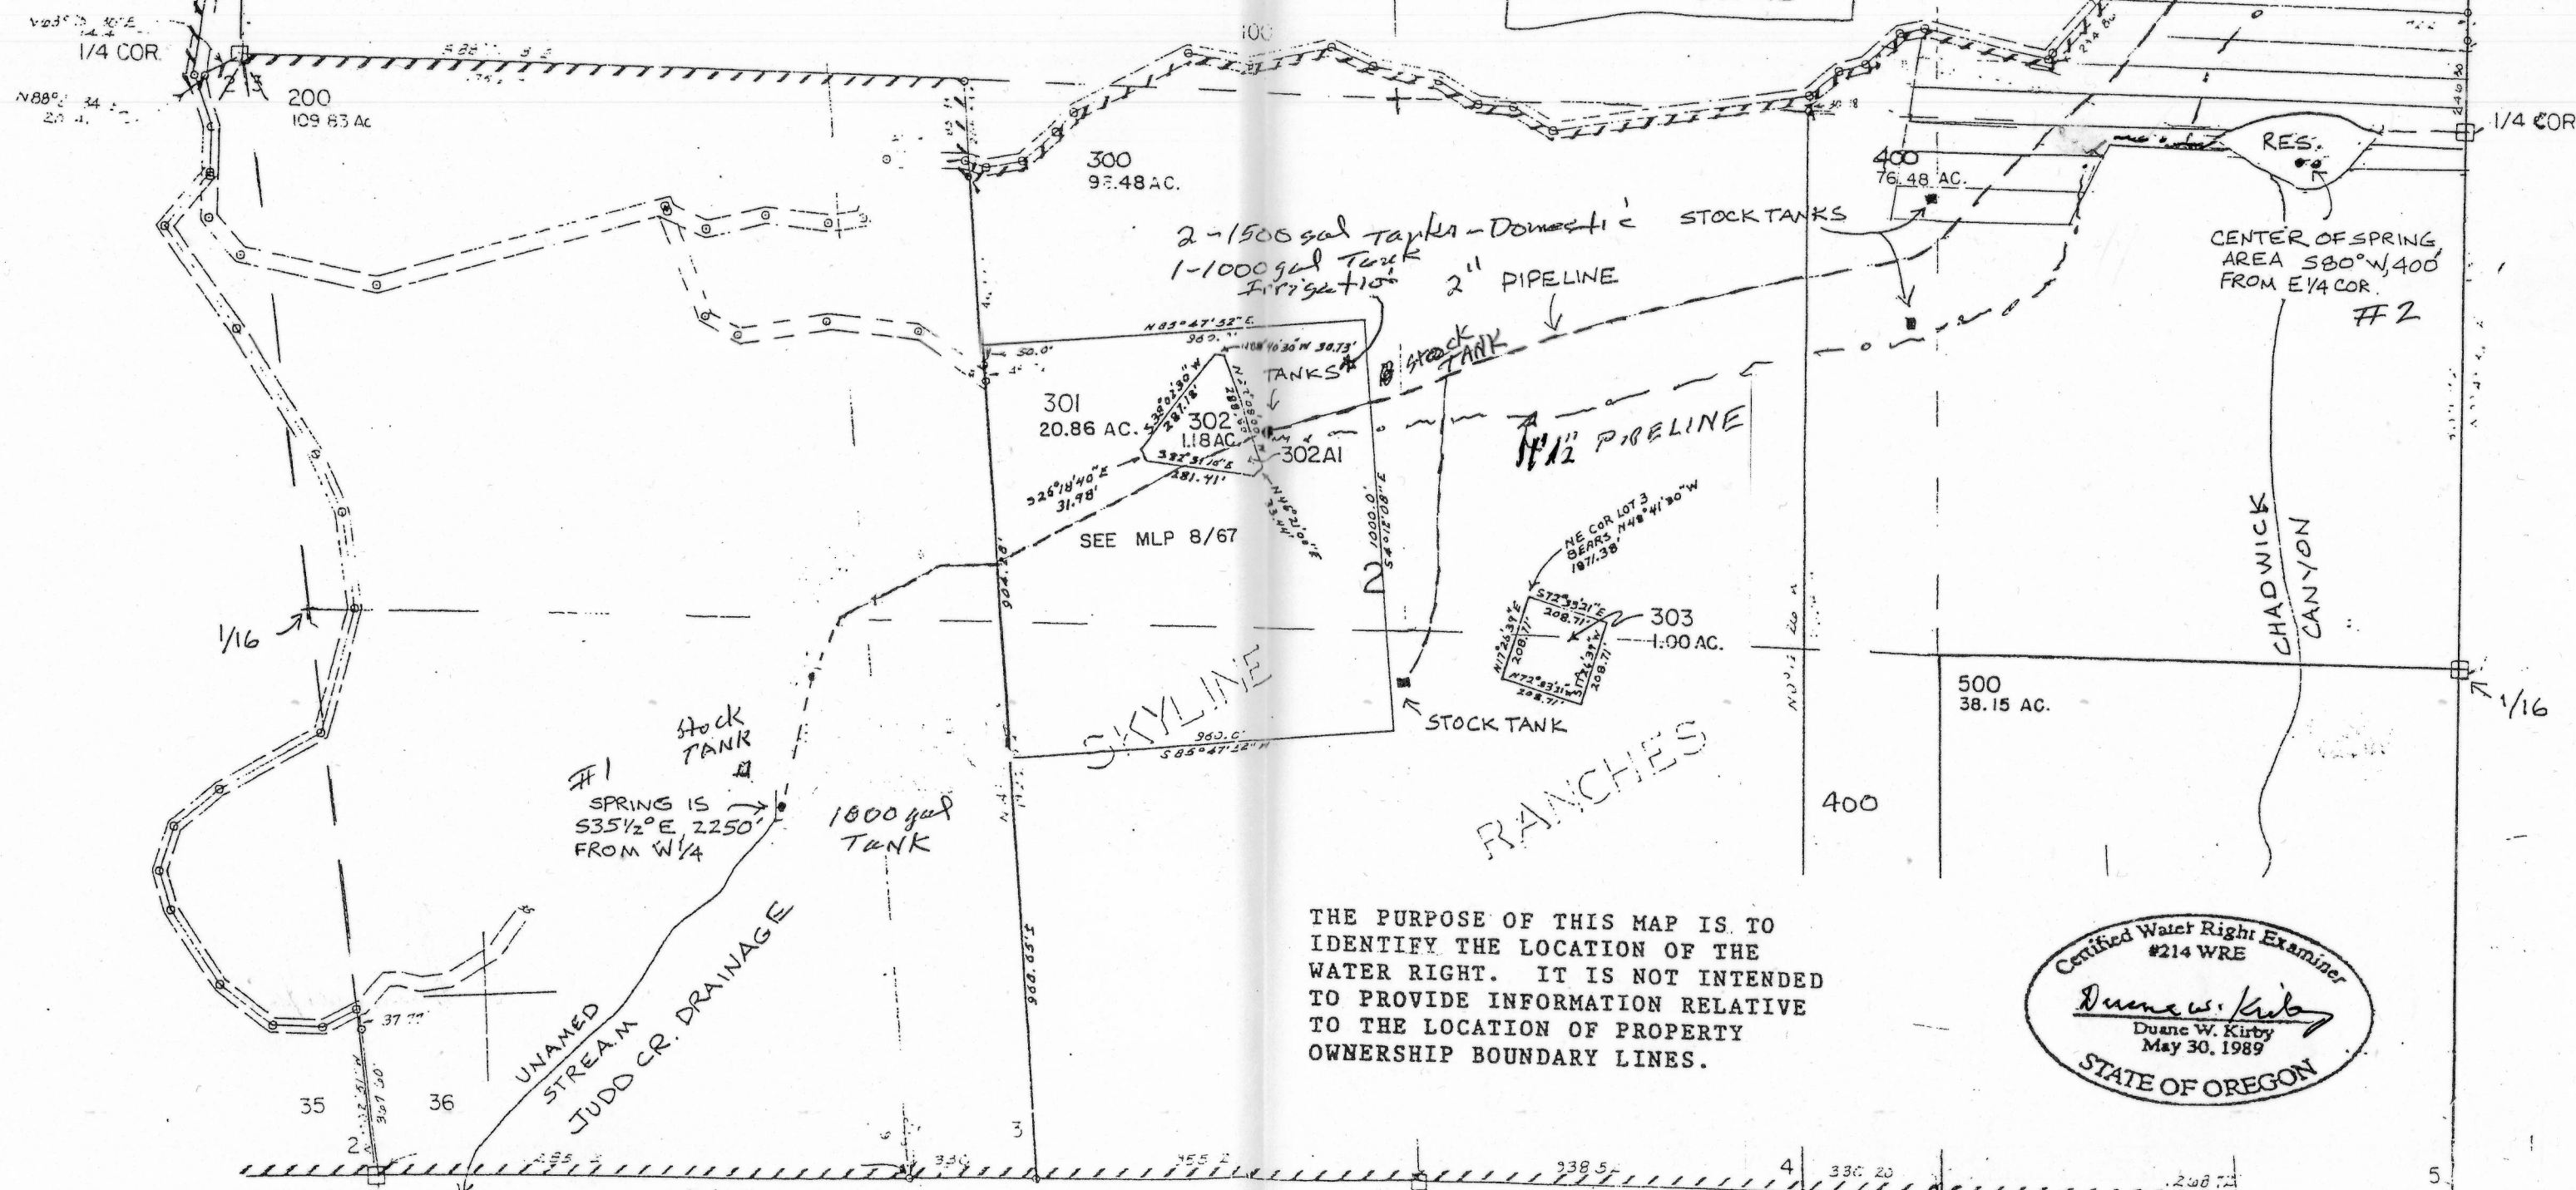

THE PURPOSE OF THIS MAP IS TO IDENTIFY THE LOCATION OF THE WATER RIGHT. IT IS NOT INTENDED TO PROVIDE INFORMATION RELATIVE TO THE LOCATION OF PROPERTY OWNERSHIP BOUNDARY LINES.

