

CLAIM OF BENEFICIAL USE


TRANSFER T-8963

IN THE NAME OF: JAMES A. ARMSTRONG

Certificate 56492 - Additional Point of Diversion

TOWNSHIP 39 SOUTH, RANGE 3 WEST, W.M.

JACKSON COUNTY, OREGON

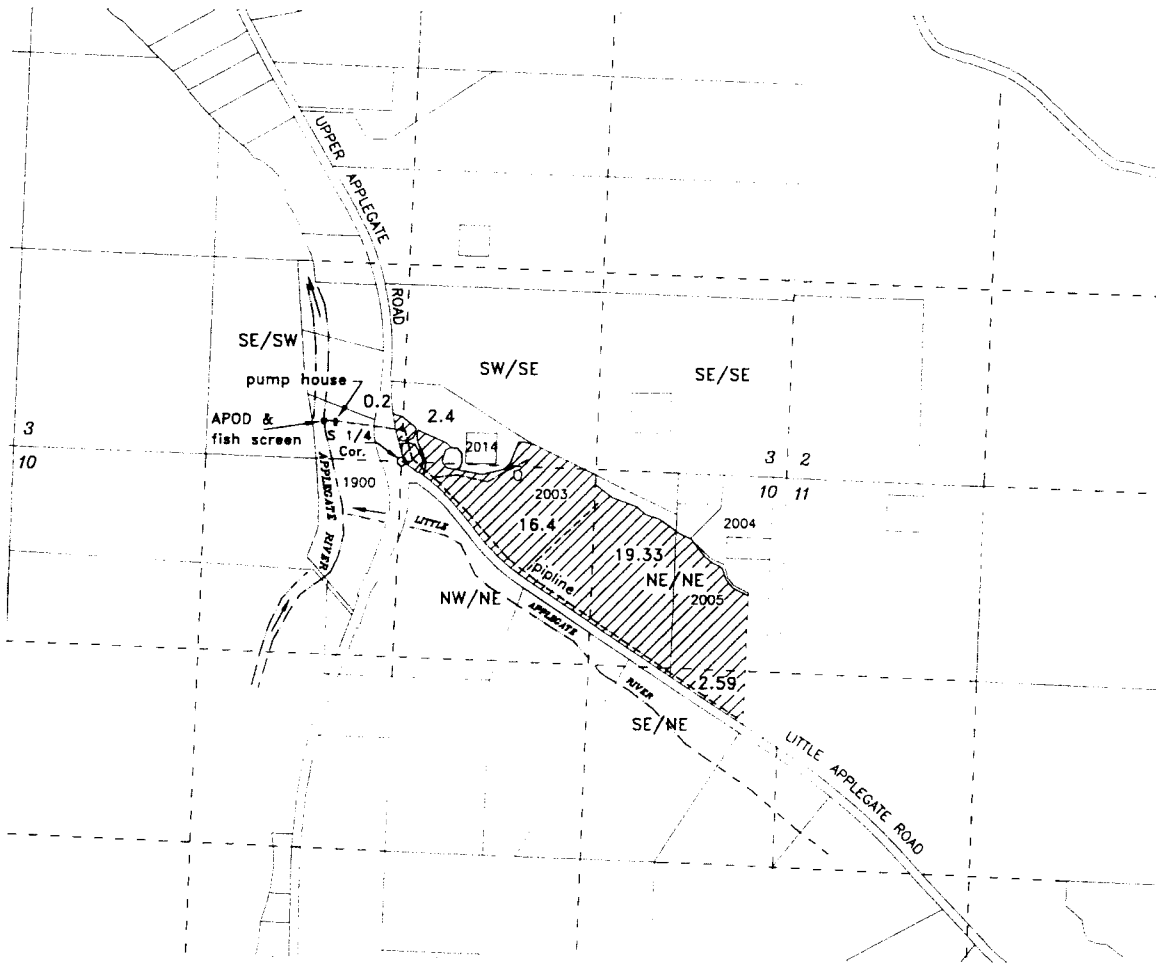

Scale

1" = 1320'


APOD - SE/SW, 260 feet North & 530 feet West from the S 1/4 corner of Section 3 Township 39S Range 3W, WM

Existing POD (of record) - SW/SE, Section 11, Township 39 South, Range 3 West, W.M., Davidson Ditch, North 39 Degrees 02 Minutes East, 1184 feet from the South 1/4 corner Section 11 per transfer order



Place of Use 40.92 Acres - Irrigation

NORTH

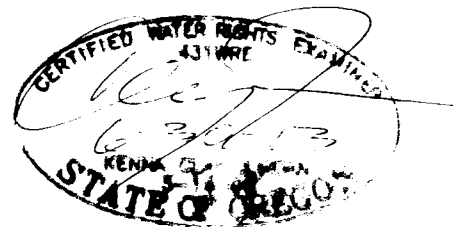

This map is not intended to provide legal dimensions or locations of property ownership lines

BASE MAP - Jackson County GIS over 2005 FSA, 8-23-2012 Google & 9-2013 Oregon Map aerial photos for assumed best fit

JORDAN ENGINEERING
460 JORDAN LANE
ROSEBURG, OR 97471
(541) 673-1931

Rev 10/14/2013 n.e.d.