


SCALE: 1"=1320'

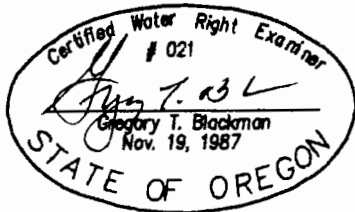

NOTE: The preparation of this map was for the purpose of identifying the location of the proposed water right and has no intent to provide dimensions or location of property ownership lines. Location information shown hereon was furnished by the applicant.

September 26, 2009

**FINAL PROOF FOR RESERVOIR
FOR WATER STORAGE.
FOR
CHRISTOPHER HEFFERNAN**

BY
BAGETT - GRIFFITH & BLACKMAN
2006 ADAMS AVENUE
LAGRANDE, OREGON 97850

Application No. R-85382
Permit No. R-13564

RECEIVED

OCT 06 2009

WATER RESOURCES DEPT
SALEM, OREGON

RECEIVED

OCT 22 2009

WATER RESOURCES DEPT
SALEM, OREGON