


CLAIM OF BENEFICIAL USE FINAL PROOF MAP

LOCATED IN THE NW¼-NW¼ OF SECTION 10,
TOWNSHIP 23 SOUTH, RANGE 12 WEST, W.M.
COOS COUNTY, OREGON

APPLICATION S-86214 PERMIT 54202

PREPARED FOR: FRANK CARDIFF
PREPARED BY: ELVIN STINGLEY
DATE PREPARED: FEBRUARY 22, 2010

NOTE:
THE P.O.D. IS A SUBMERSIBLE PUMP HANGING OFF
DOCK THAT IS LOCATED 66 FEET SOUTH AND 78
FEET WEST FROM THE WEST 1/16 CORNER OF
SECTION 10

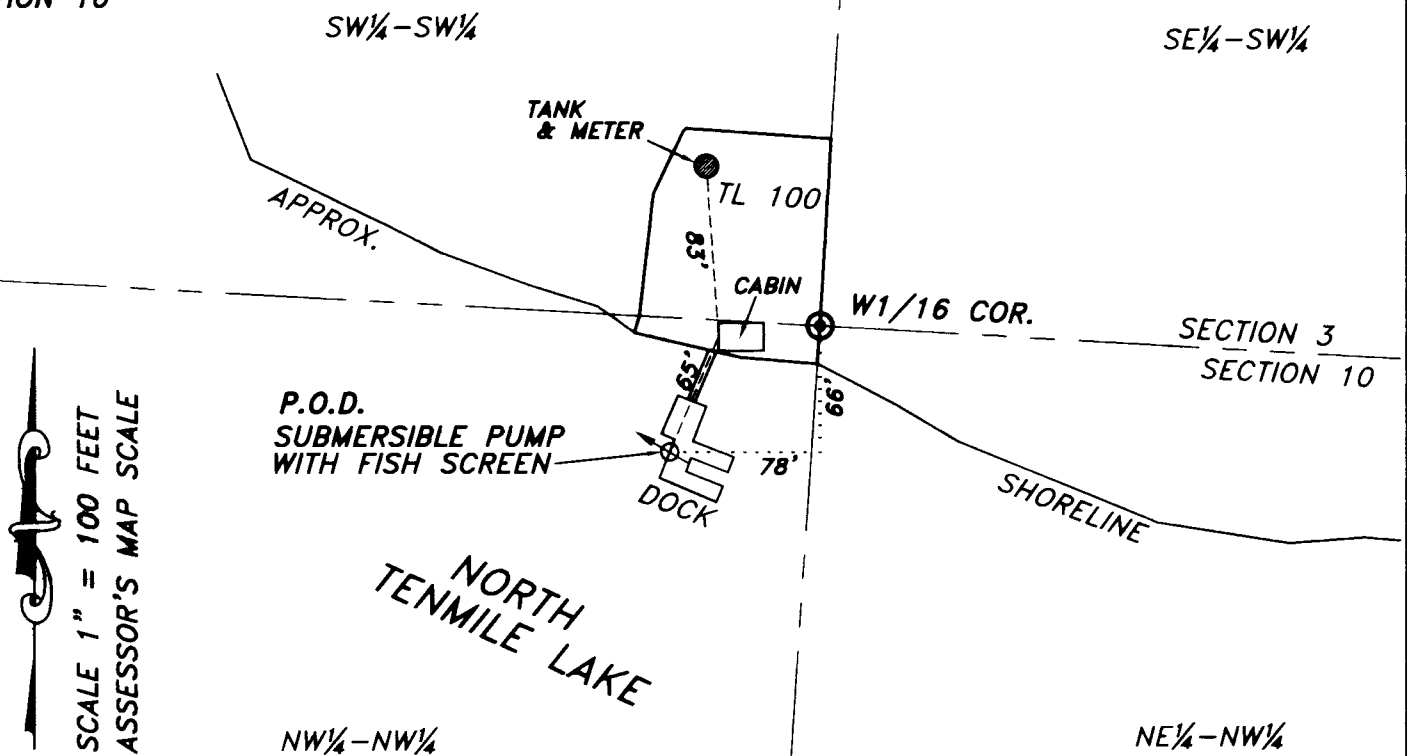

LEGEND

⊙ P.O.B.

⊙ P.O.D.

--- 1" POLY H2O LINE

RECEIVED

FEB 26 2010

WATER RESOURCES DEPT
SALEM, OREGON



EXPIRES 12/31/2011

**Stuntzner Engineering
& Forestry, L.L.C.**

ENGINEERING • LAND SURVEYING • FORESTRY
PLANNING • WATER RIGHTS

706 South 4th St.
Post Office Box 118
Coos Bay, Oregon 97420

Phone: (541) 267-2872
Fax: (541) 267-6688

EXAMINERS DISCLAIMER STATEMENT

THE PREPARATION OF THIS MAP WAS FOR THE PURPOSE OF
IDENTIFYING THE LOCATION OF THE WATER RIGHT ONLY AND
HAS NO INTENT TO PROVIDE DIMENSIONS OR LOCATION OF
PROPERTY OWNERSHIP LINES.