

COBU MAP # 0459

12 13  
23 24

LOT 10  
(NW 1/4 NE 1/4)

(NE 1/4 NE 1/4)

SW 1/4 NE 1/4

LOT 9  
(SE 1/4 NE 1/4)

THIS MAP IS FOR THE PURPOSE  
OF IDENTIFYING THE LOCATION  
OF THE WATER RIGHT ONLY.  
THERE IS NO INTENT TO PROVIDE  
DIMENSIONS OR LOCATION OF  
PROPERTY OWNERSHIP LINES.

4190'

23

APPROXIMATE LOCATION OF  
UNNAMED STREAM

NW 1/4 SE 1/4

(NE 1/4 SE 1/4)

LOT 8

METER

HOUSE

METER IS NORTH 357 FEET AND  
EAST 170 FEET FROM THE POD.

170'

357'

PIPE LINE

DOCK

1346'

POINT OF DIVERSION & FISH SCREEN  
IS SOUTH 4190 FEET AND WEST 1346  
FEET FROM THE NE CORNER OF SEC. 23.

SILTCOOS LAKE

LOT 6

(SW 1/4 SE 1/4)

LOT 7

(SE 1/4 SE 1/4)

RECEIVED

SEP 28 2009

WATER RESOURCES DEPT  
SALEM, OREGON

FINAL PROOF SURVEY  
CLAIM OF BENEFICIAL USE  
WATER RIGHTS MAP

MID COAST BASIN  
UNDER

PERMIT 54072

APPLICATION NO. S-85647

MAP 19-12-23-4, TL 1001


NE 1/4 SE 1/4, SEC. 23, T19S, R12W, W.M.  
LANE COUNTY, OREGON

FOR: CHRIS L. AND DARLA J. HAGUE  
83630 KIECHLE ARM ROAD  
FLORENCE, OREGON 97439

PREPARED BY: WOBBE & ASSOCIATES, INC.  
510 KINGWOOD ST. / P.O. BOX 3093  
FLORENCE, OR 97439

DATE: SEPTEMBER 15, 2009

23 24  
26 25

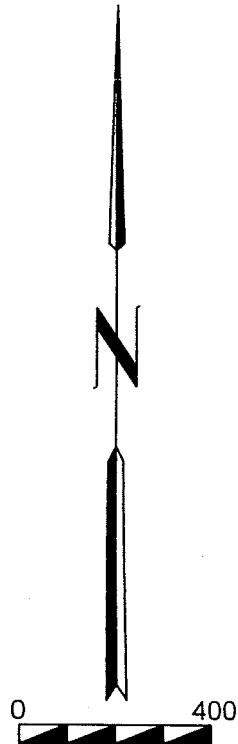

DC200910330 WR FP

